DATE	NO.	SIZE	MAKE	OPEN	TURNS
1923	1	6"		R	20 1/2
	1	8'-N	SPL		

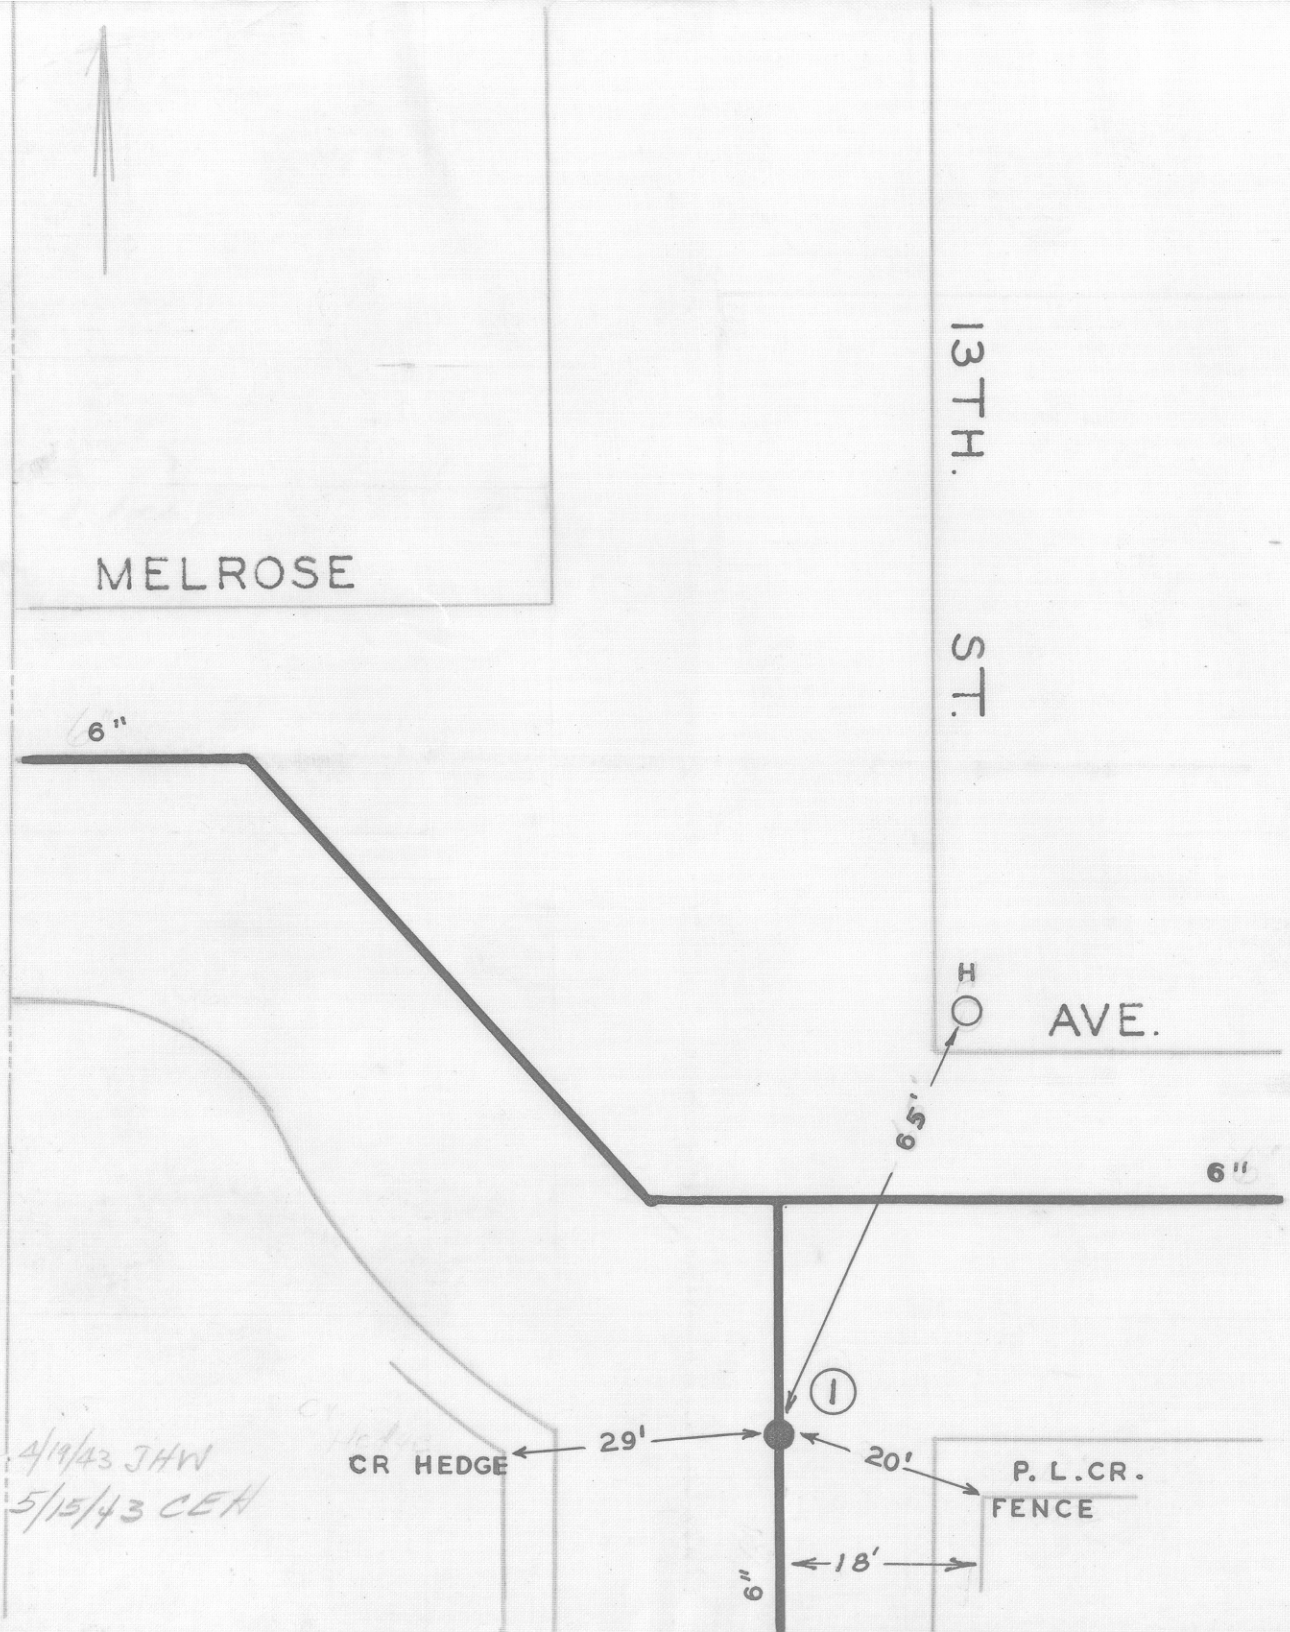

CITY OF ROANOKE—WATER DEP'T

VALVE DIAGRAM

MELROSE AVE. & 13TH. ST. N. W.

SEC. MAP 222

DATE

PAGE NO. NW.141