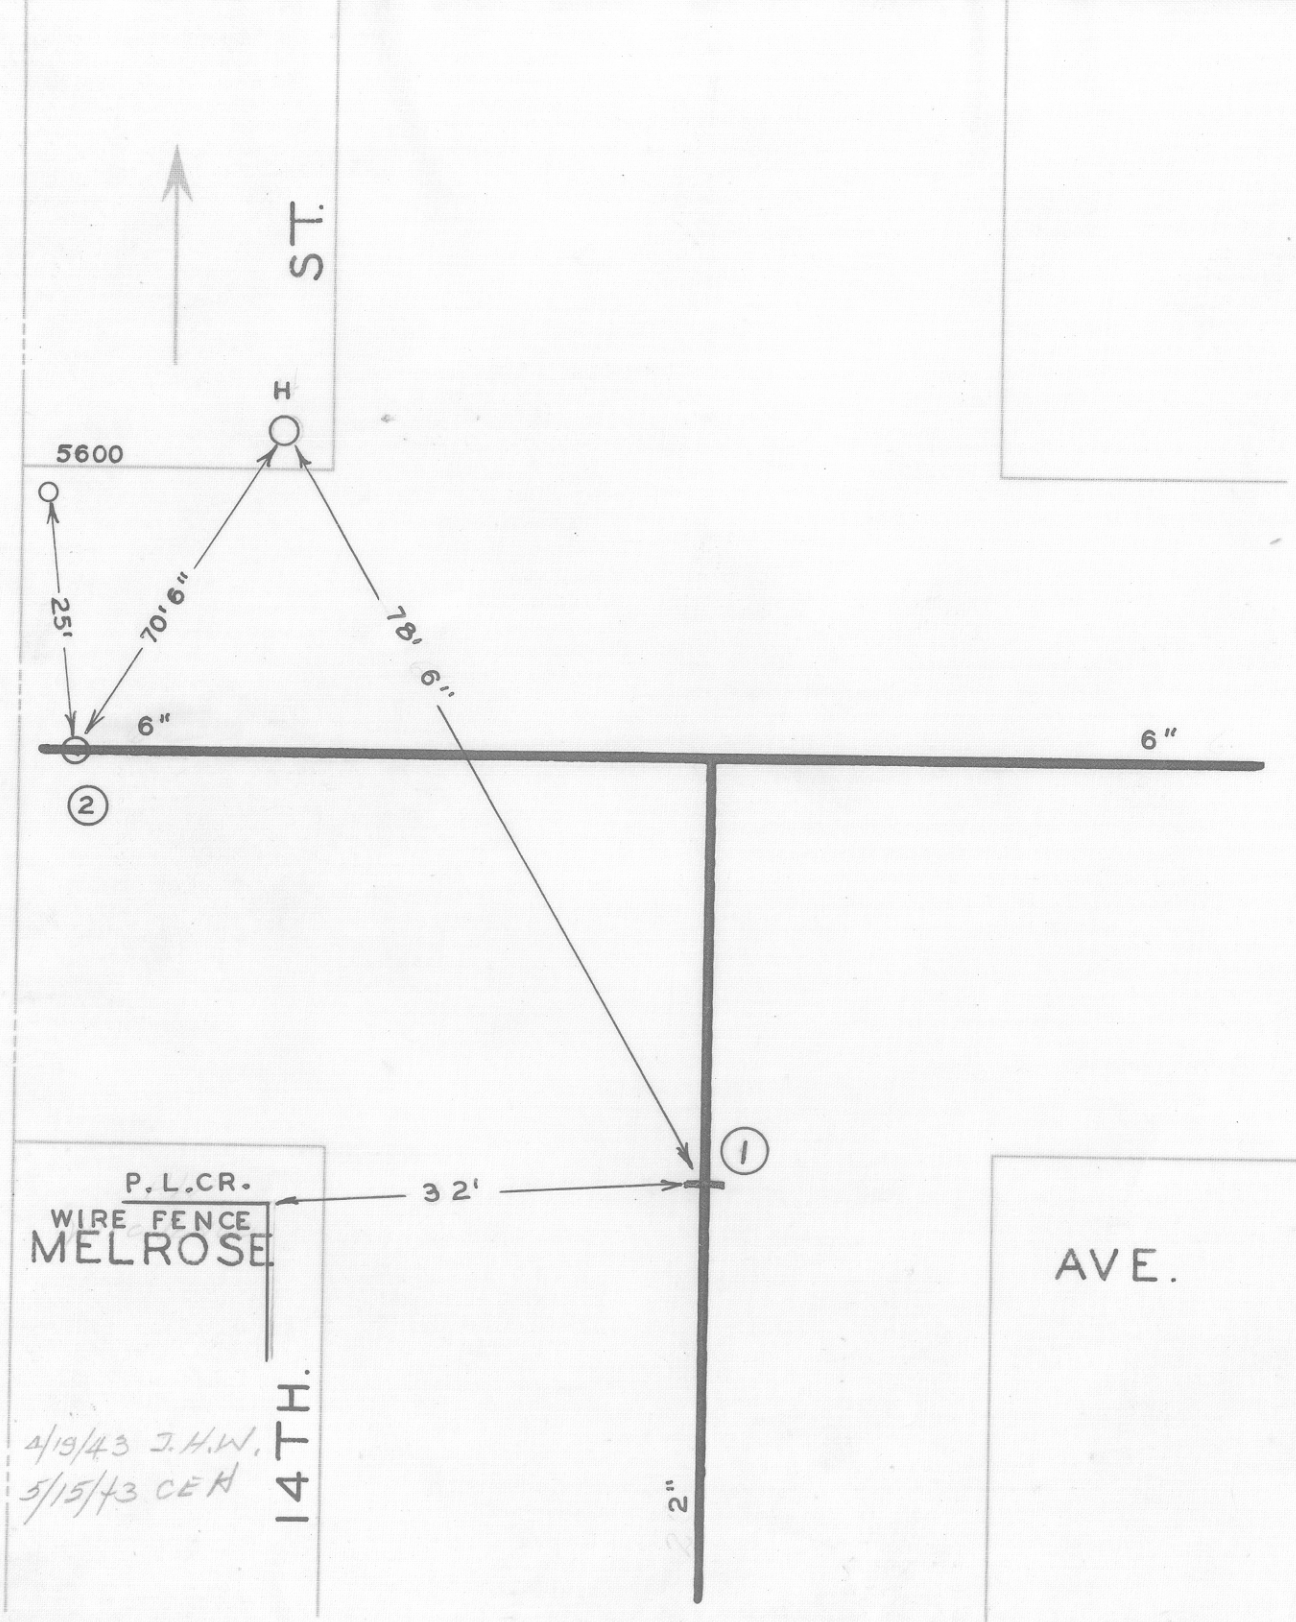

DATE	NO.	SIZE	MAKE	OPEN	TURNS
1939	1	2"		R	7
	2	1"	PITOT STA.		
	1	0	SPL		

CITY OF ROANOKE—WATER DEP'T

VALVE DIAGRAM

MELROSE AVE. & 14TH. ST. N.W.

SEC. MAP 222

DATE

PAGE NO. NW 142