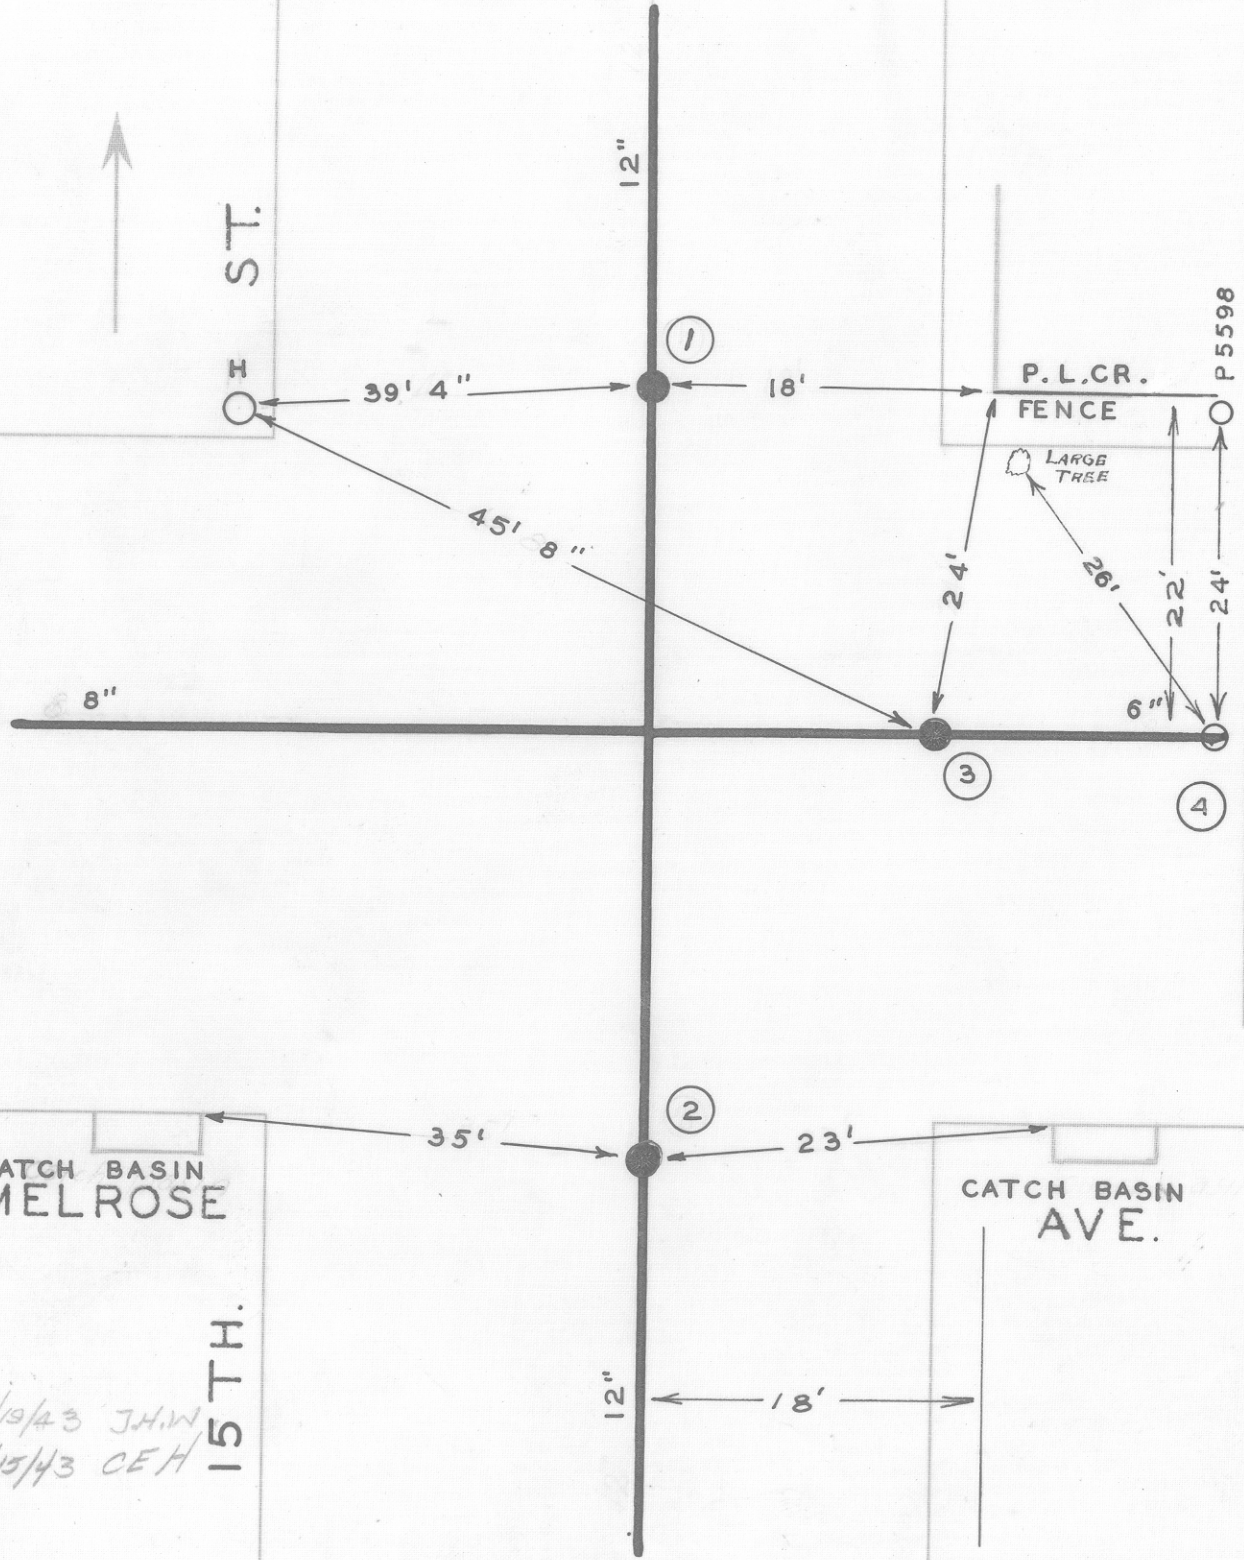

DATE	NO.	SIZE	MAKE	OPEN	TURNS
1922	1	12"		R	38
1926	2	12"		R	38 1/2
1923	3	6"		R	20
	4	1"	PITOT STA.		
	1	0	N PL		
	2	7'-N	S PL		
	3	9'-W	E PL		

CITY OF ROANOKE—WATER DEP'T

VALVE DIAGRAM

MELROSE AVE. & 15TH. ST. N. W.

SEC. MAP 222

DATE

PAGE NO. NW 143