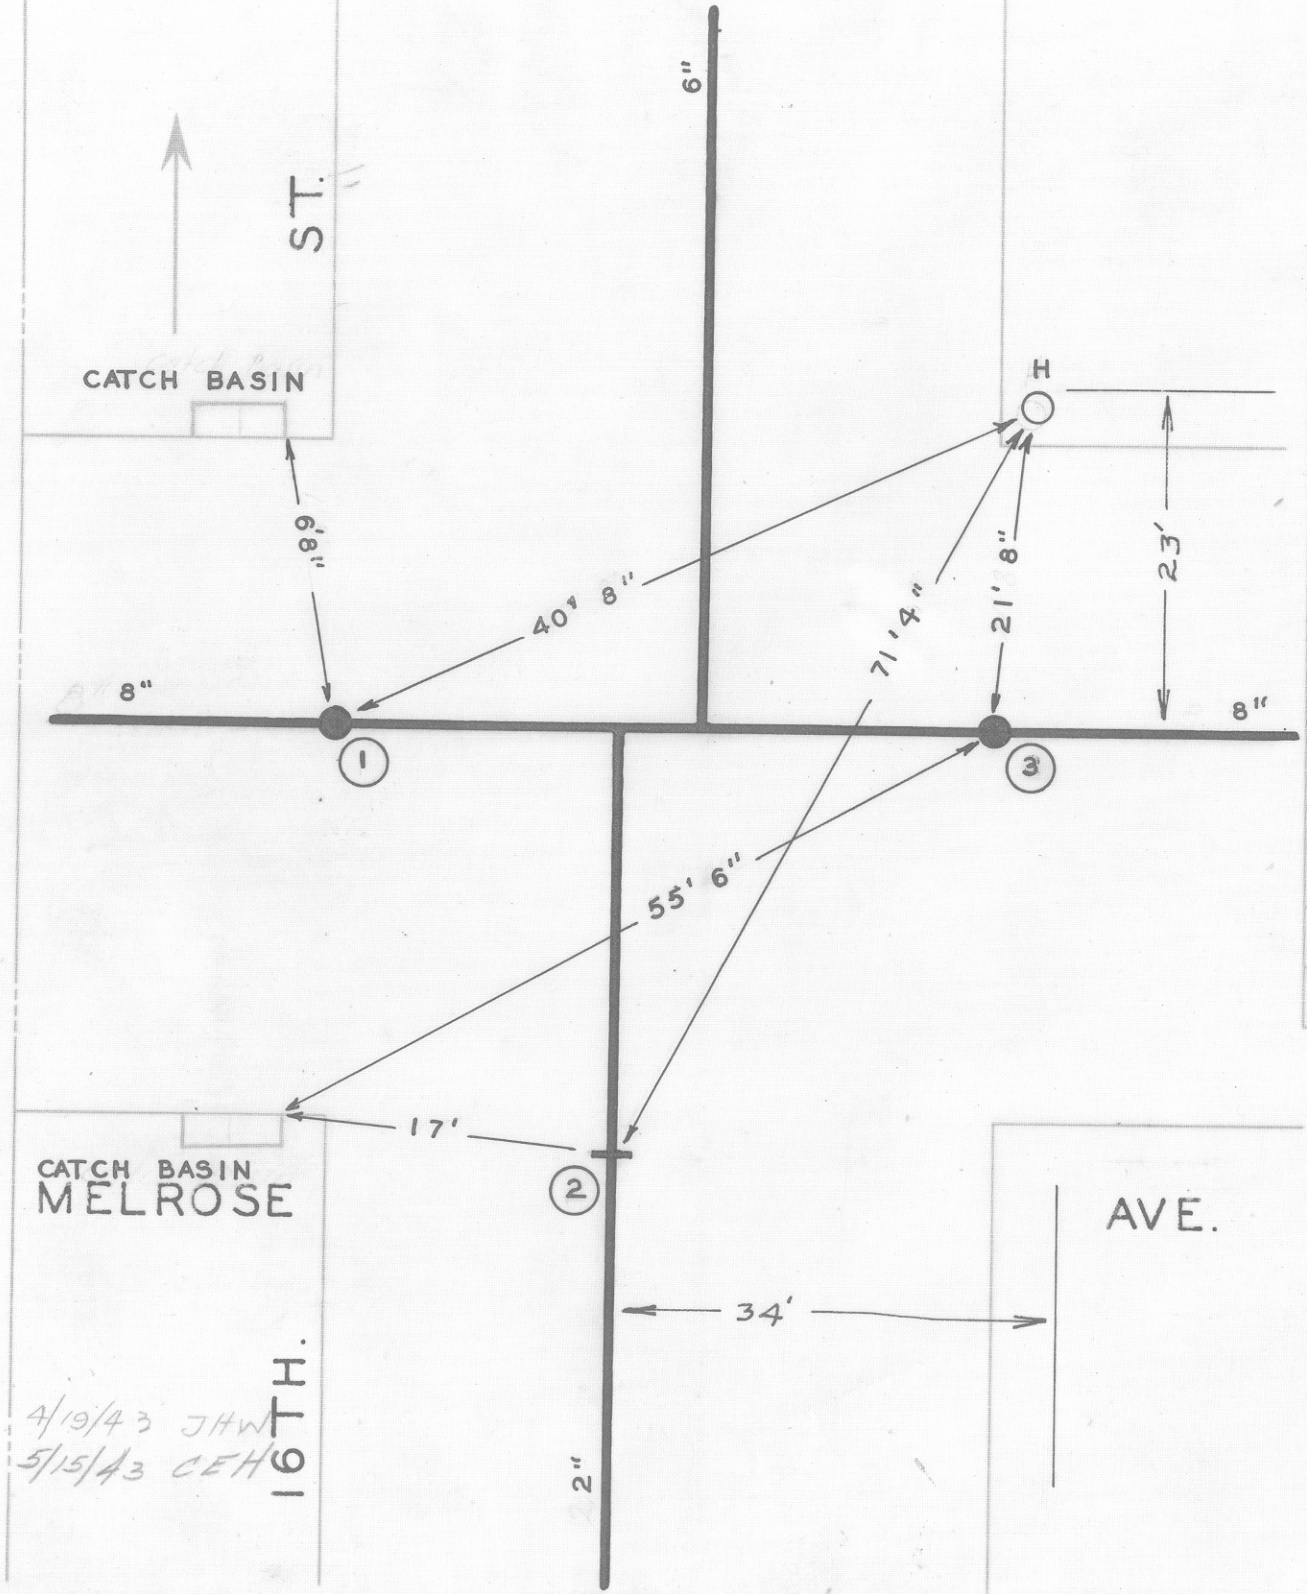

DATE	NO.	SIZE	MAKE	OPEN	TURNS
1909	1	8"		R	16 1/2
1943	2	2"	DARLING	R	7 1/2
1922	3	8"		R	25 1/2
	1	8'-E	WPL		
	2	16'-N	SPL		
	3	10'-W	EPL		

CITY OF ROANOKE—WATER DEP'T

VALVE DIAGRAM

MELROSE AVE. & 16TH. ST. N. W.

SEC. MAP 222

DATE

PAGE NO. N.W. 144