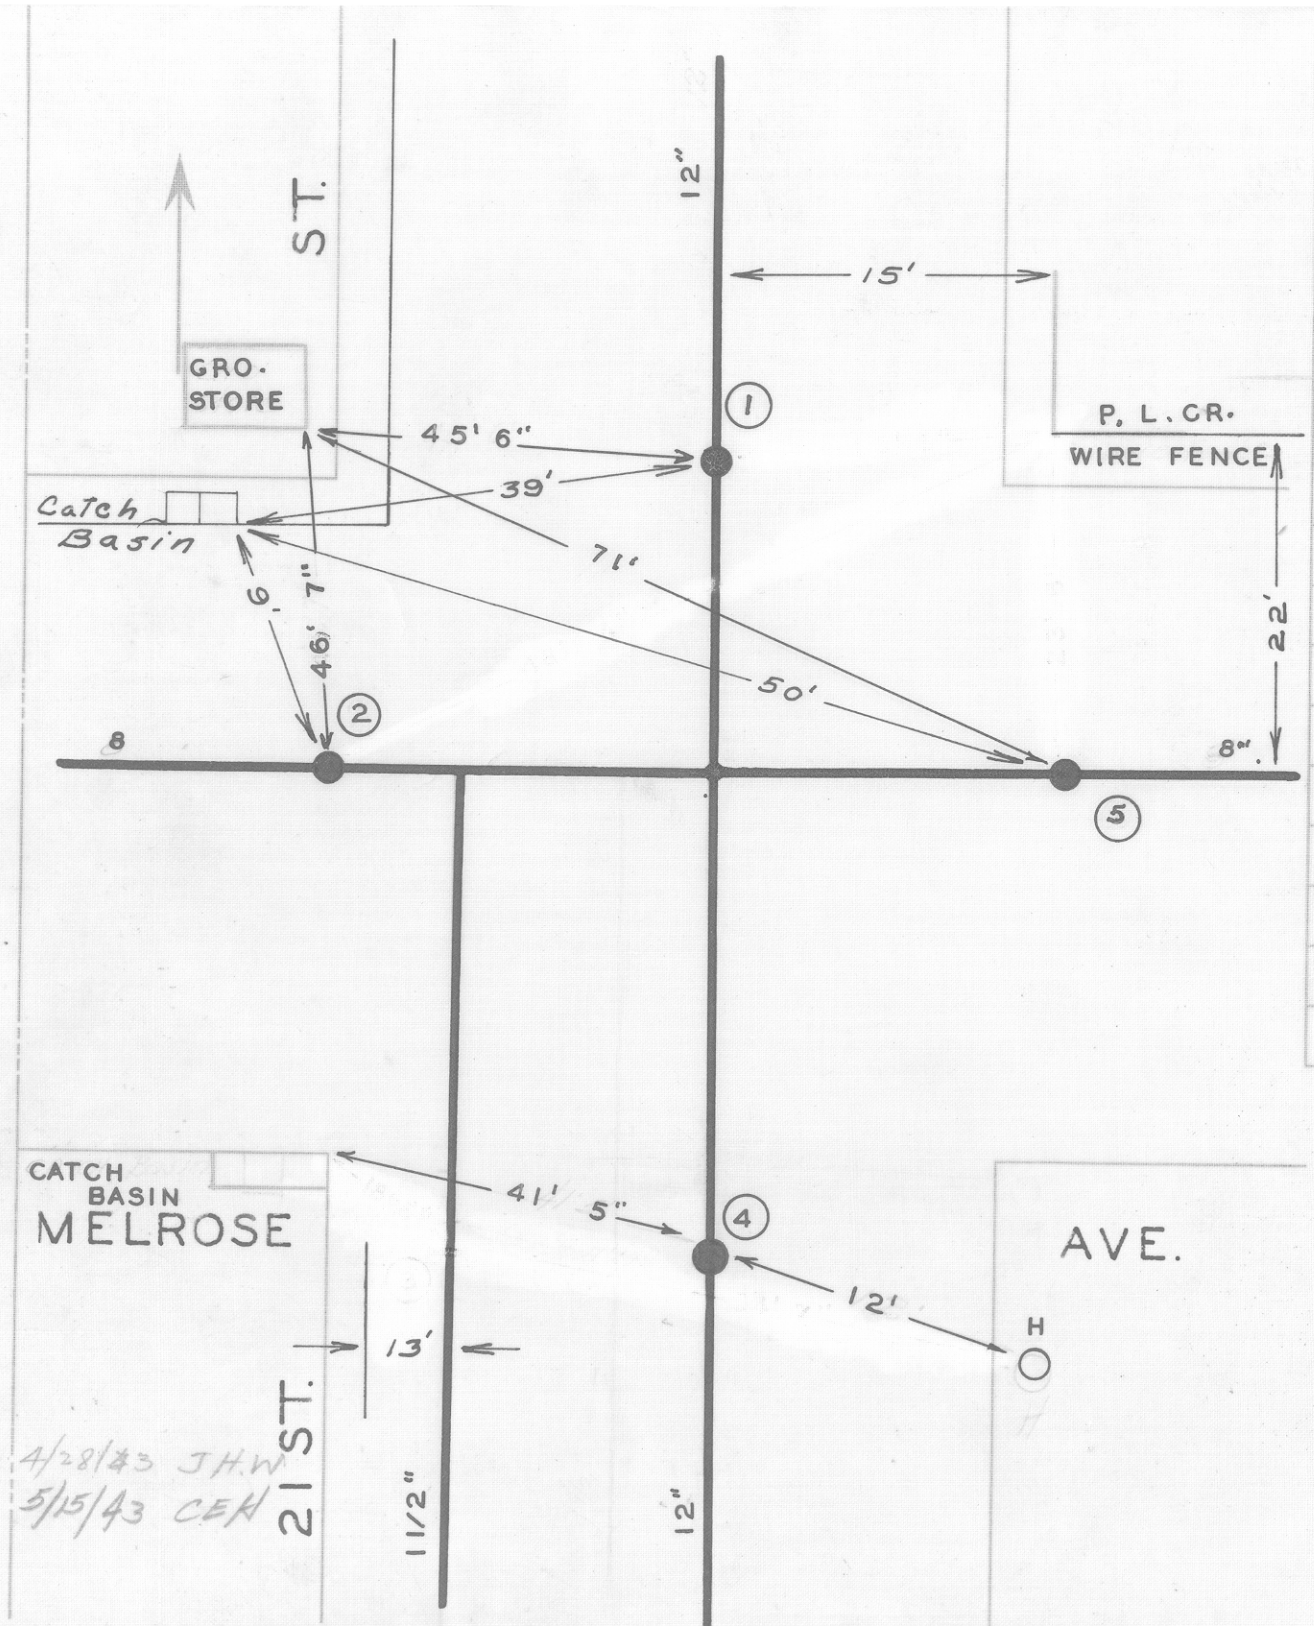

DATE	NO.	SIZE	MAKE	OPEN	TURNS
1932	1	12"		R	39 1/2
1909	2	8"		R	16
1913	ABANDONDED				
1932	4	12"		R	39 1/2
1909	5	8"		R	26
	1	0	NPL		
	2	7' E	WPL		
	4	0	SPL		
	5	0	EPL		

CITY OF ROANOKE—WATER DEP'T

VALVE DIAGRAM

MELROSE AVE. & 21 ST. ST. N. W.

SEC. MAP 232

DATE

PAGE NO NW.203