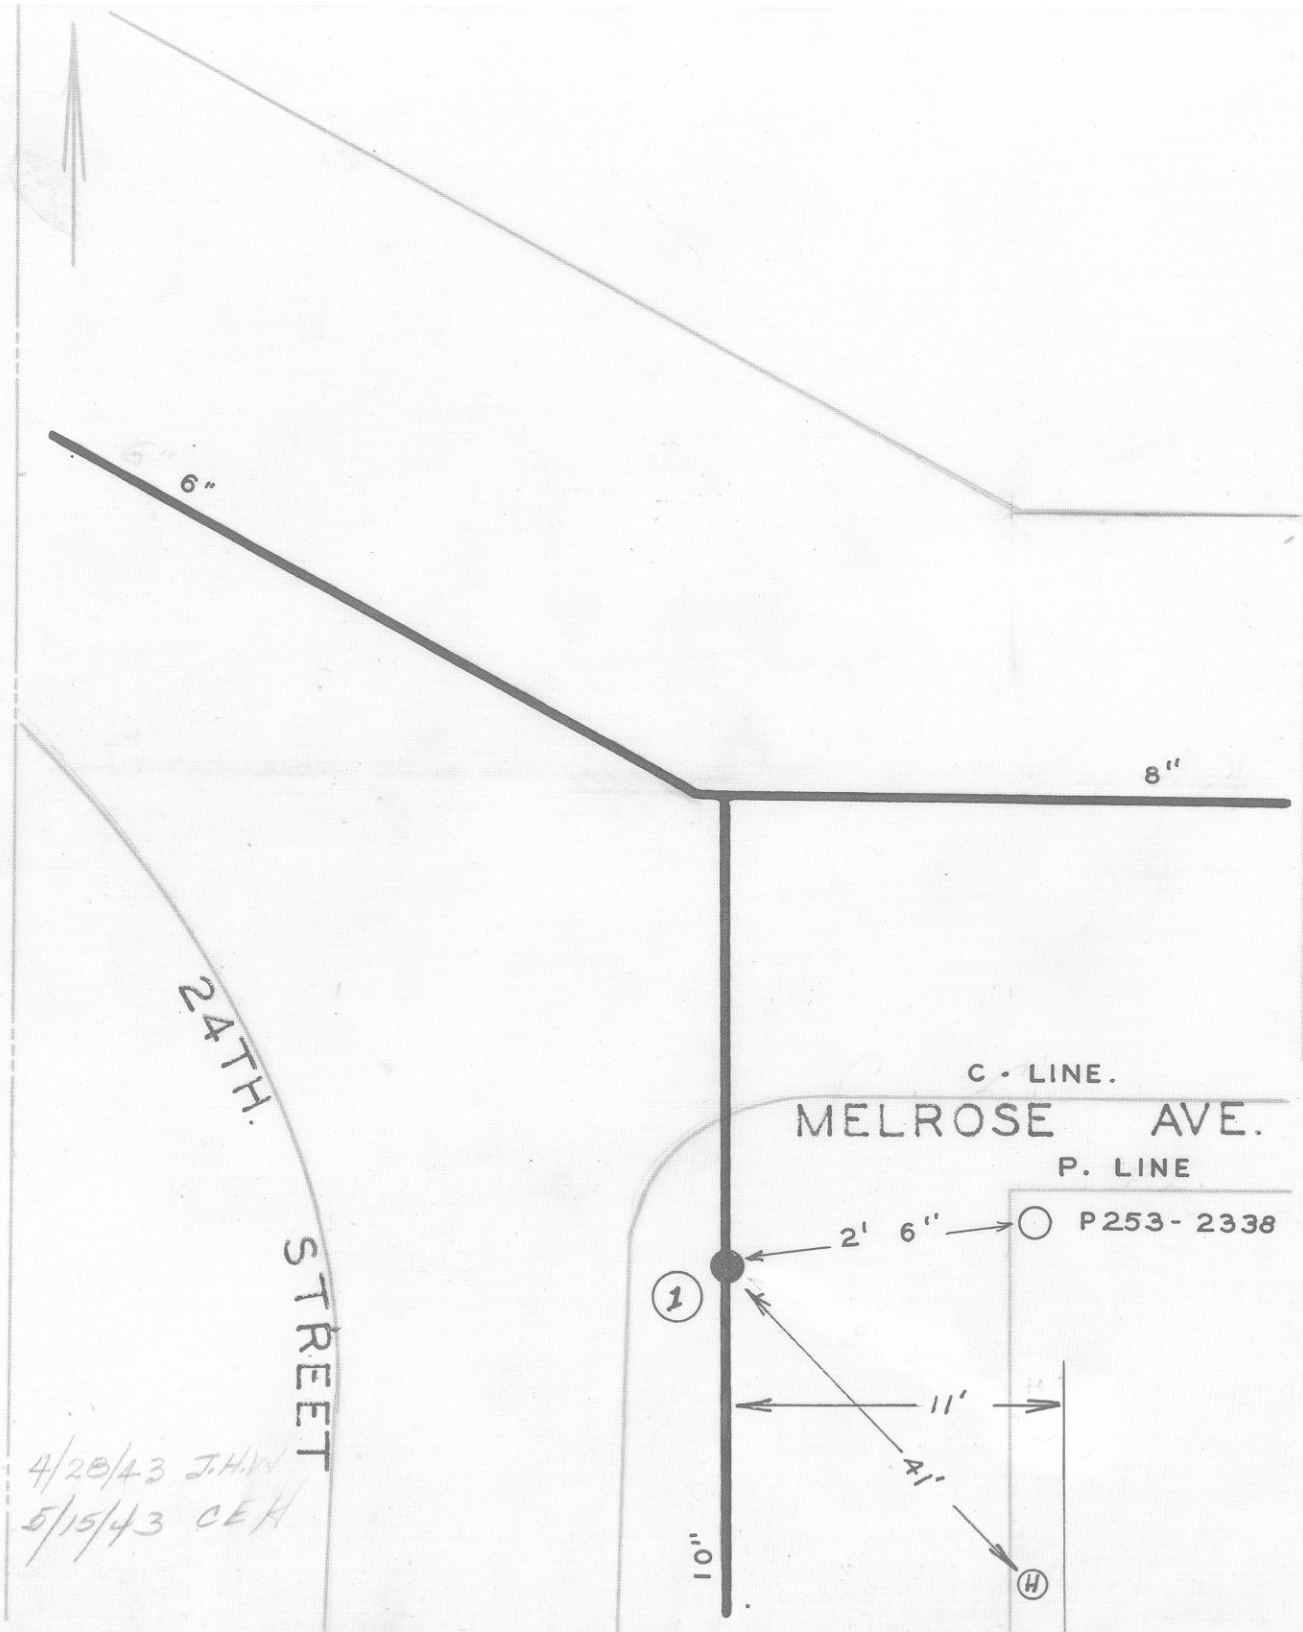


| DATE | NO. | SIZE | MAKE | OPEN | TURNS |
|---|---|---|---|---|---|
| 1937 | 1 | 10" | | R | 33 |
| | | | | | |
| | | | | | |
| | 1 | 6"-S | SPL | | |
| | | | | | |
| | | | | | |

CITY OF ROANOKE—WATER DEP'T

VALVE DIAGRAM

MELROSE AVE. & 24TH. ST. N. W. WEST INNERSECTION

SEC. MAP 232.

DATE

PAGE NO. NW207