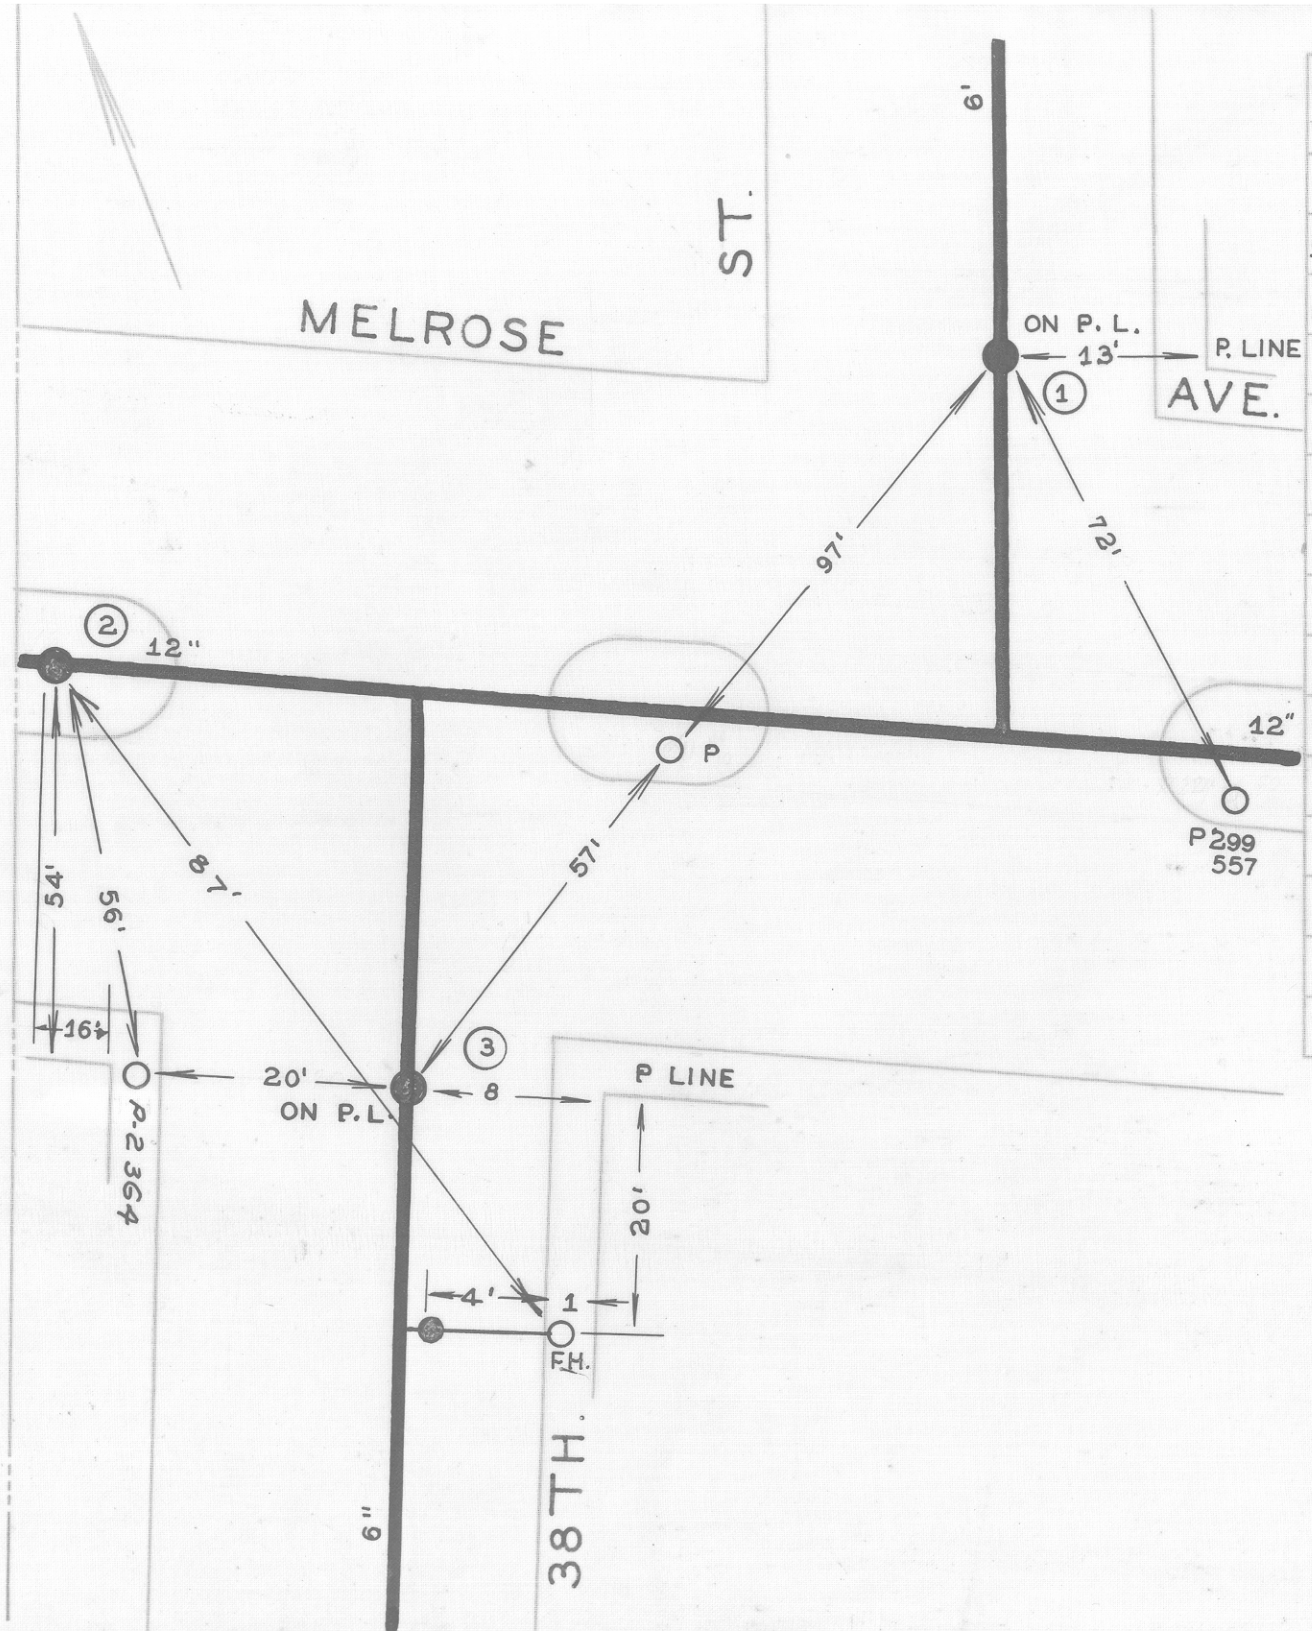

DATE	NO.	SIZE	MAKE	OPEN	TURNS
1950	1	6"	DARLING	R	20
1950	2	12"	DARLING	R	39
1950	3	6"	DARLING	R	20
	1	0	NPL		
	2	16'-W	WPL		
	3	0	SPL		

CITY OF ROANOKE—WATER DEP'T

VALVE DIAGRAM

MELROSE AVENUE &

38TH. STREET N.W.

36TH. ST. ON MARKER

SEC. MAP 266

DATE

PAGE NO. N.W.361