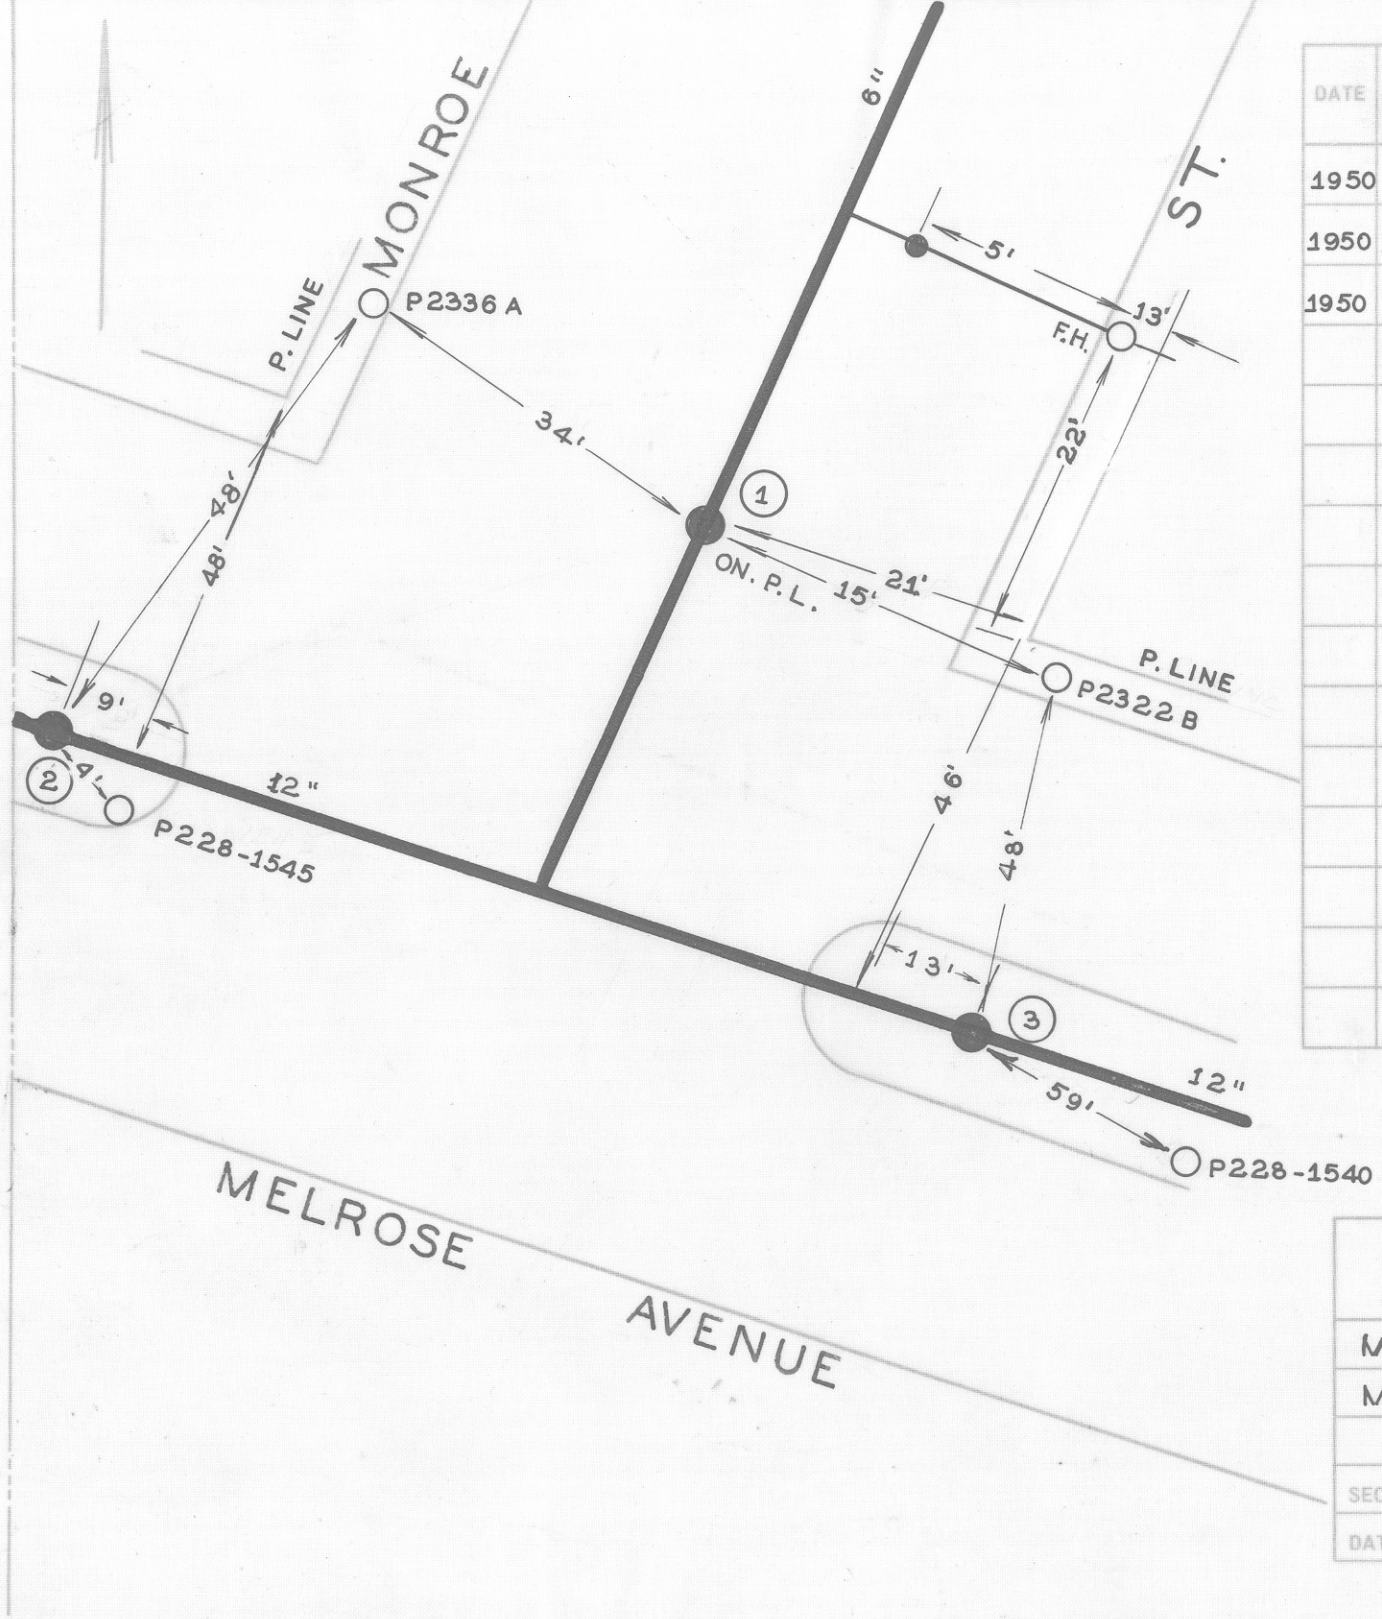

DATE	NO.	SIZE	MAKE	OPEN	TURNS
1950	1	6"	DARLING	R	20
1950	2	12"	DARLING	R	39
1950	3	12"	DARLING	R	39
	1	0	NPL		
	2	9'-W	WPL		
	3	13'-E	EPL		

CITY OF ROANOKE—WATER DEP'T

VALVE DIAGRAM

MELROSE AVENUE &

MONROE STREET N.W.

SEC. MAP 276

DATE

PAGE NO NW366