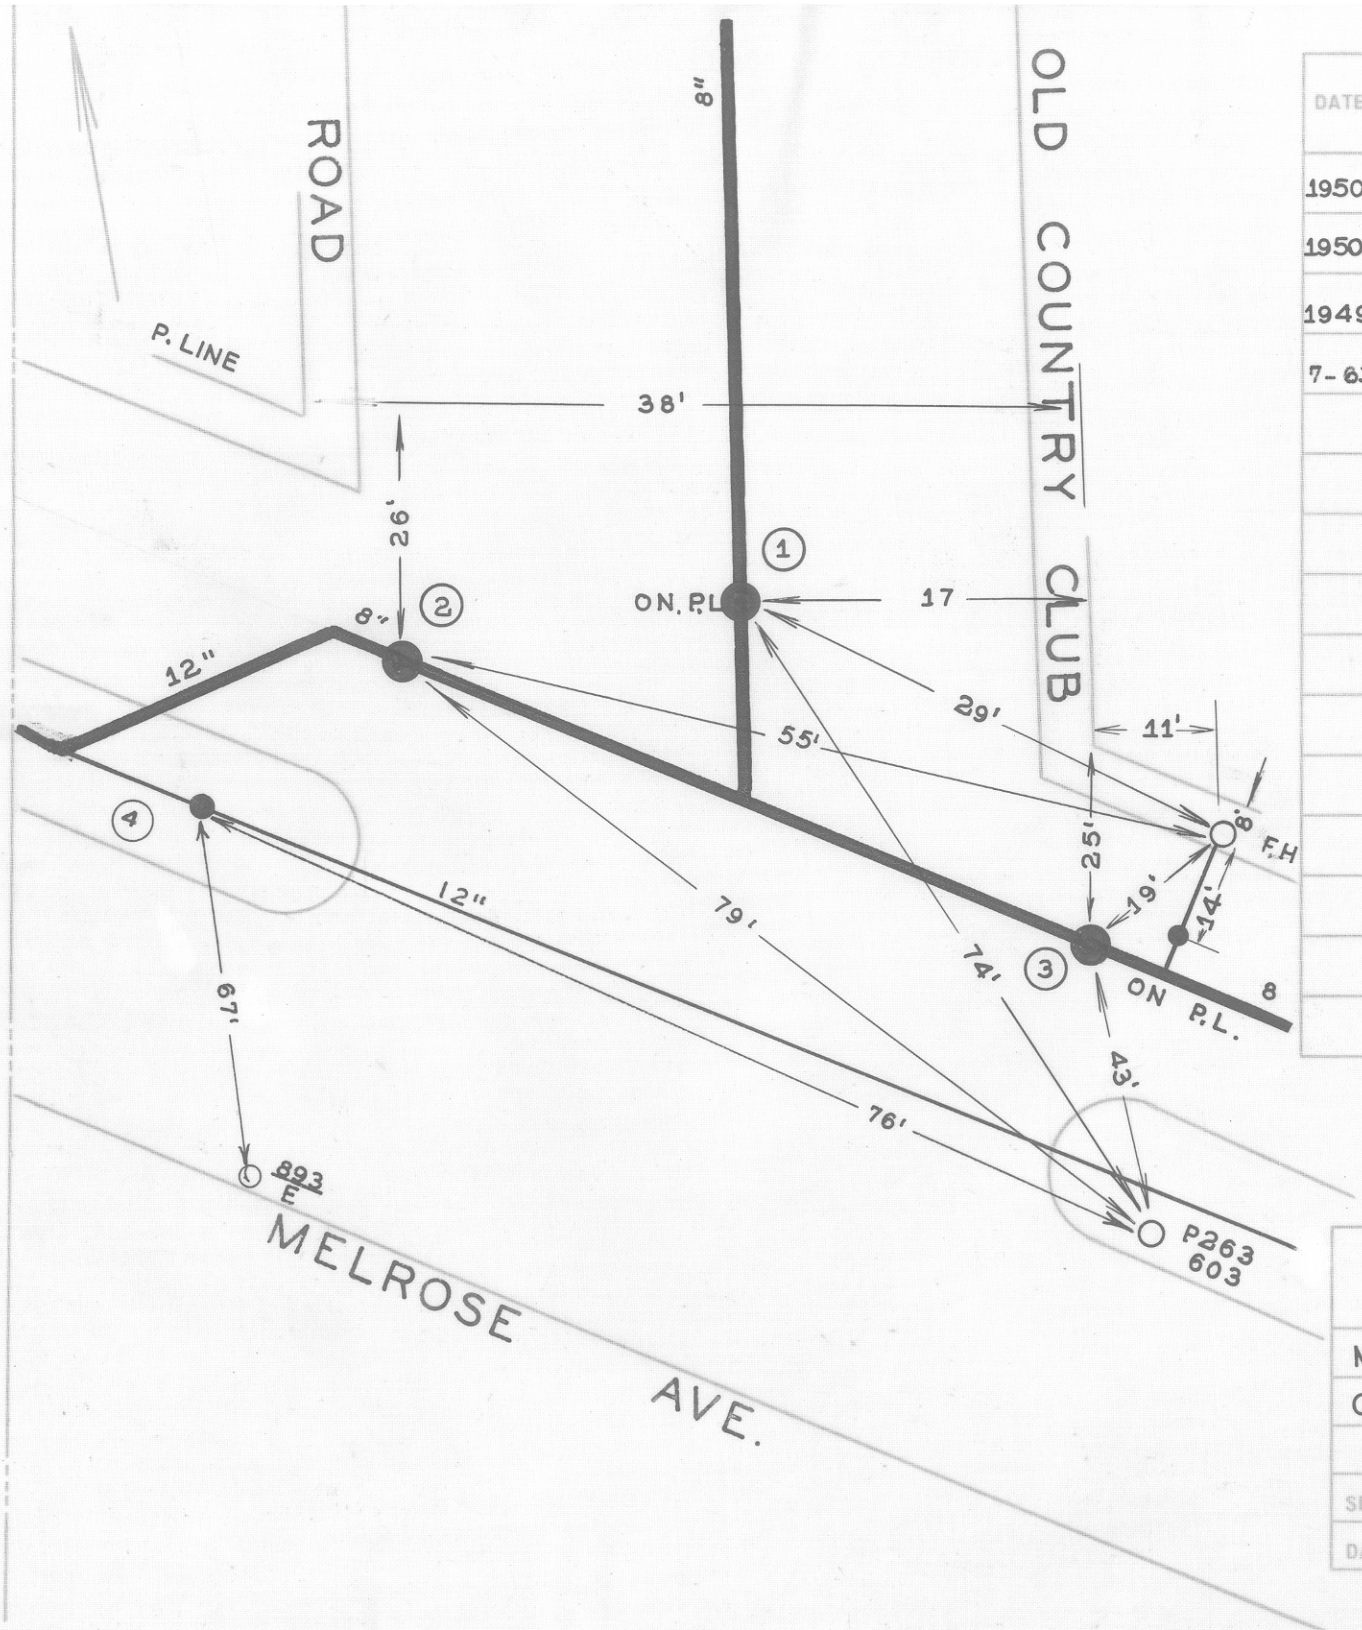

DATE	NO.	SIZE	MAKE	OPEN	TURNS
1950	1	8"	DARLING	R	26 1/2
1950	2	8"	DARLING	R	27
1949	3	8"	DARLING	R	26 1/2
7-63	4	12"	MUELLER	R	
	1	0	NPL		
	2	0	W PL		
	3	0	E PL		
	4	12'W	W.P.L.		

CITY OF ROANOKE—WATER DEP'T

VALVE DIAGRAM

MELROSE AVENUE &

OLD COUNTRY CLUB

SEC. MAP 266

DATE

PAGE NO. N.W. 357