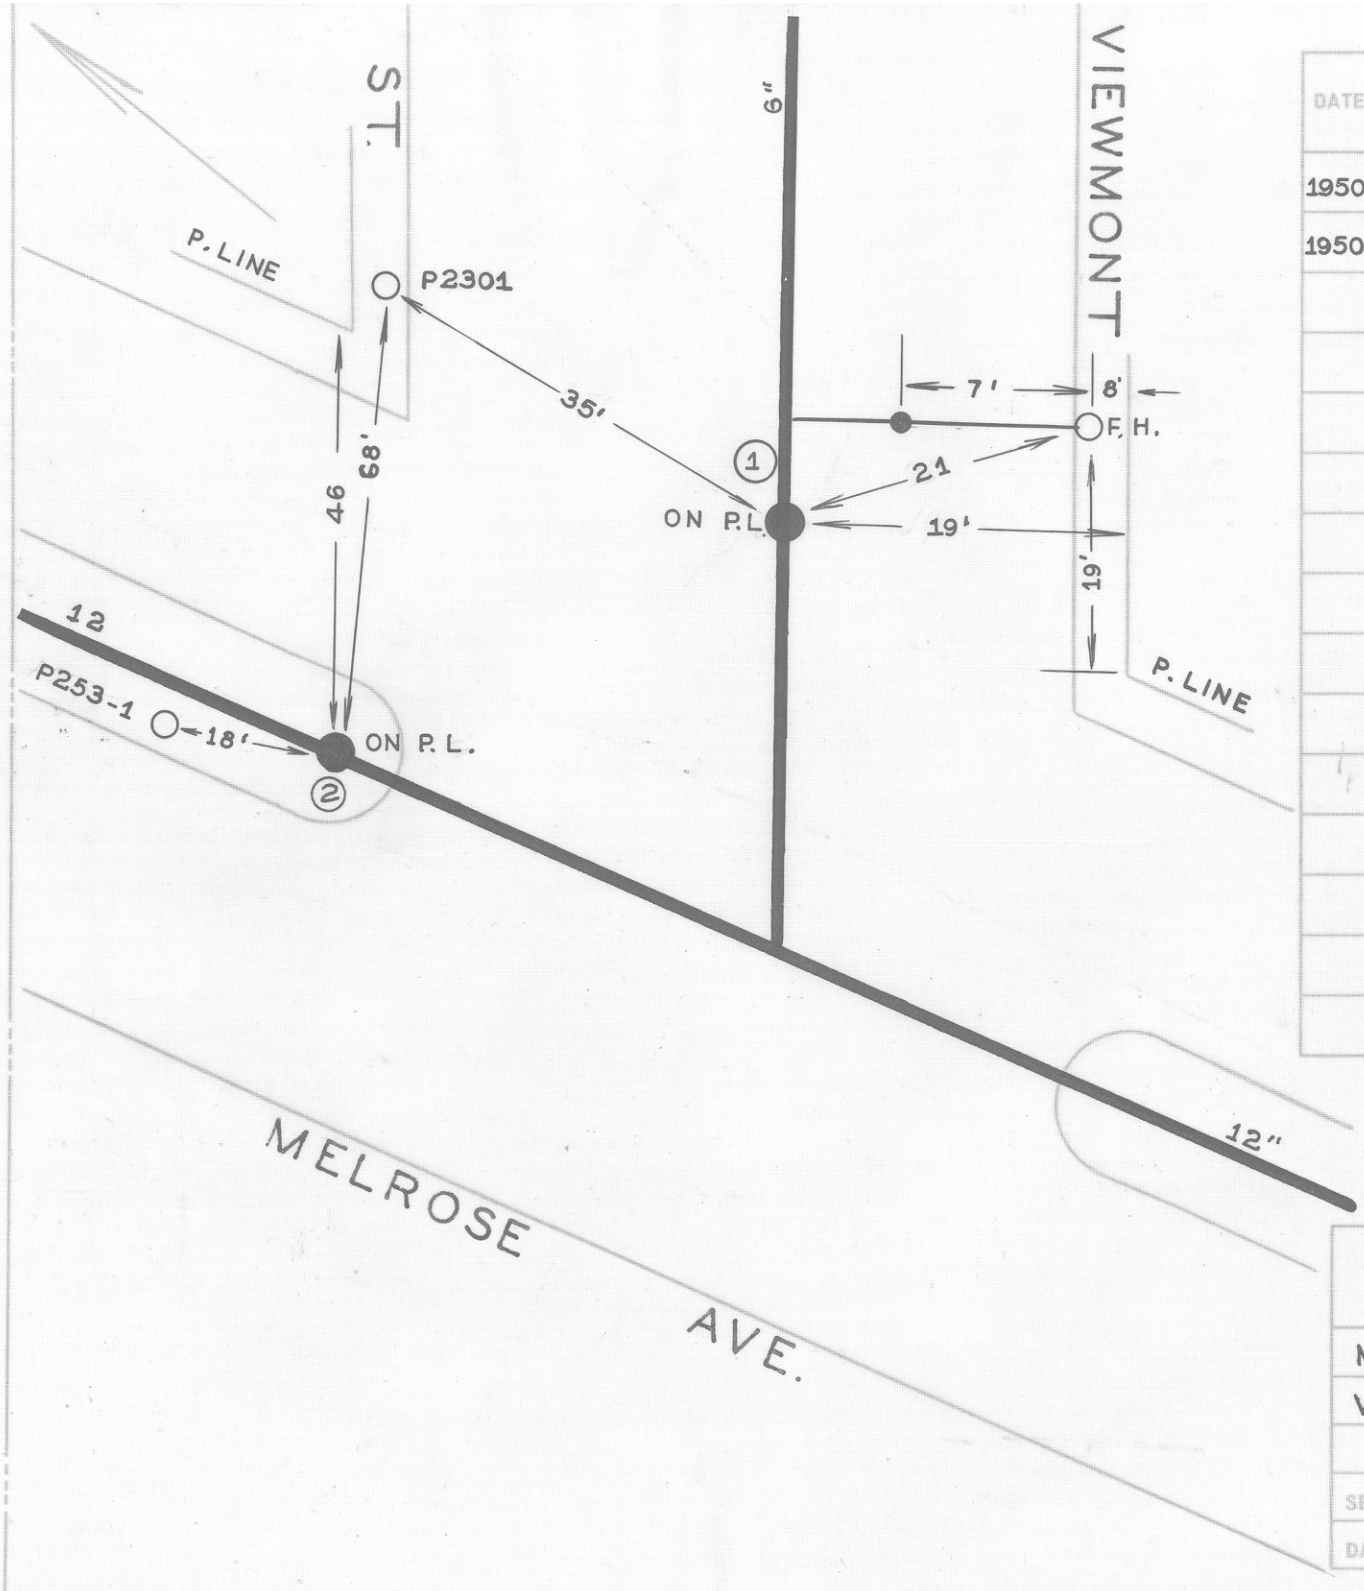

DATE	NO.	SIZE	MAKE	OPEN	TURNS
1950	1	6"	DARLING	R	20
1950	2	12	DARLING	R	41
	1	0	NPL		
	2	0	W.PL		

CITY OF ROANOKE—WATER DEP'T

VALVE DIAGRAM

MELROSE AVENUE &

VIEWMONT STREET N.W.

SEC. MAP 266

DATE

PAGE NO. N.W.358