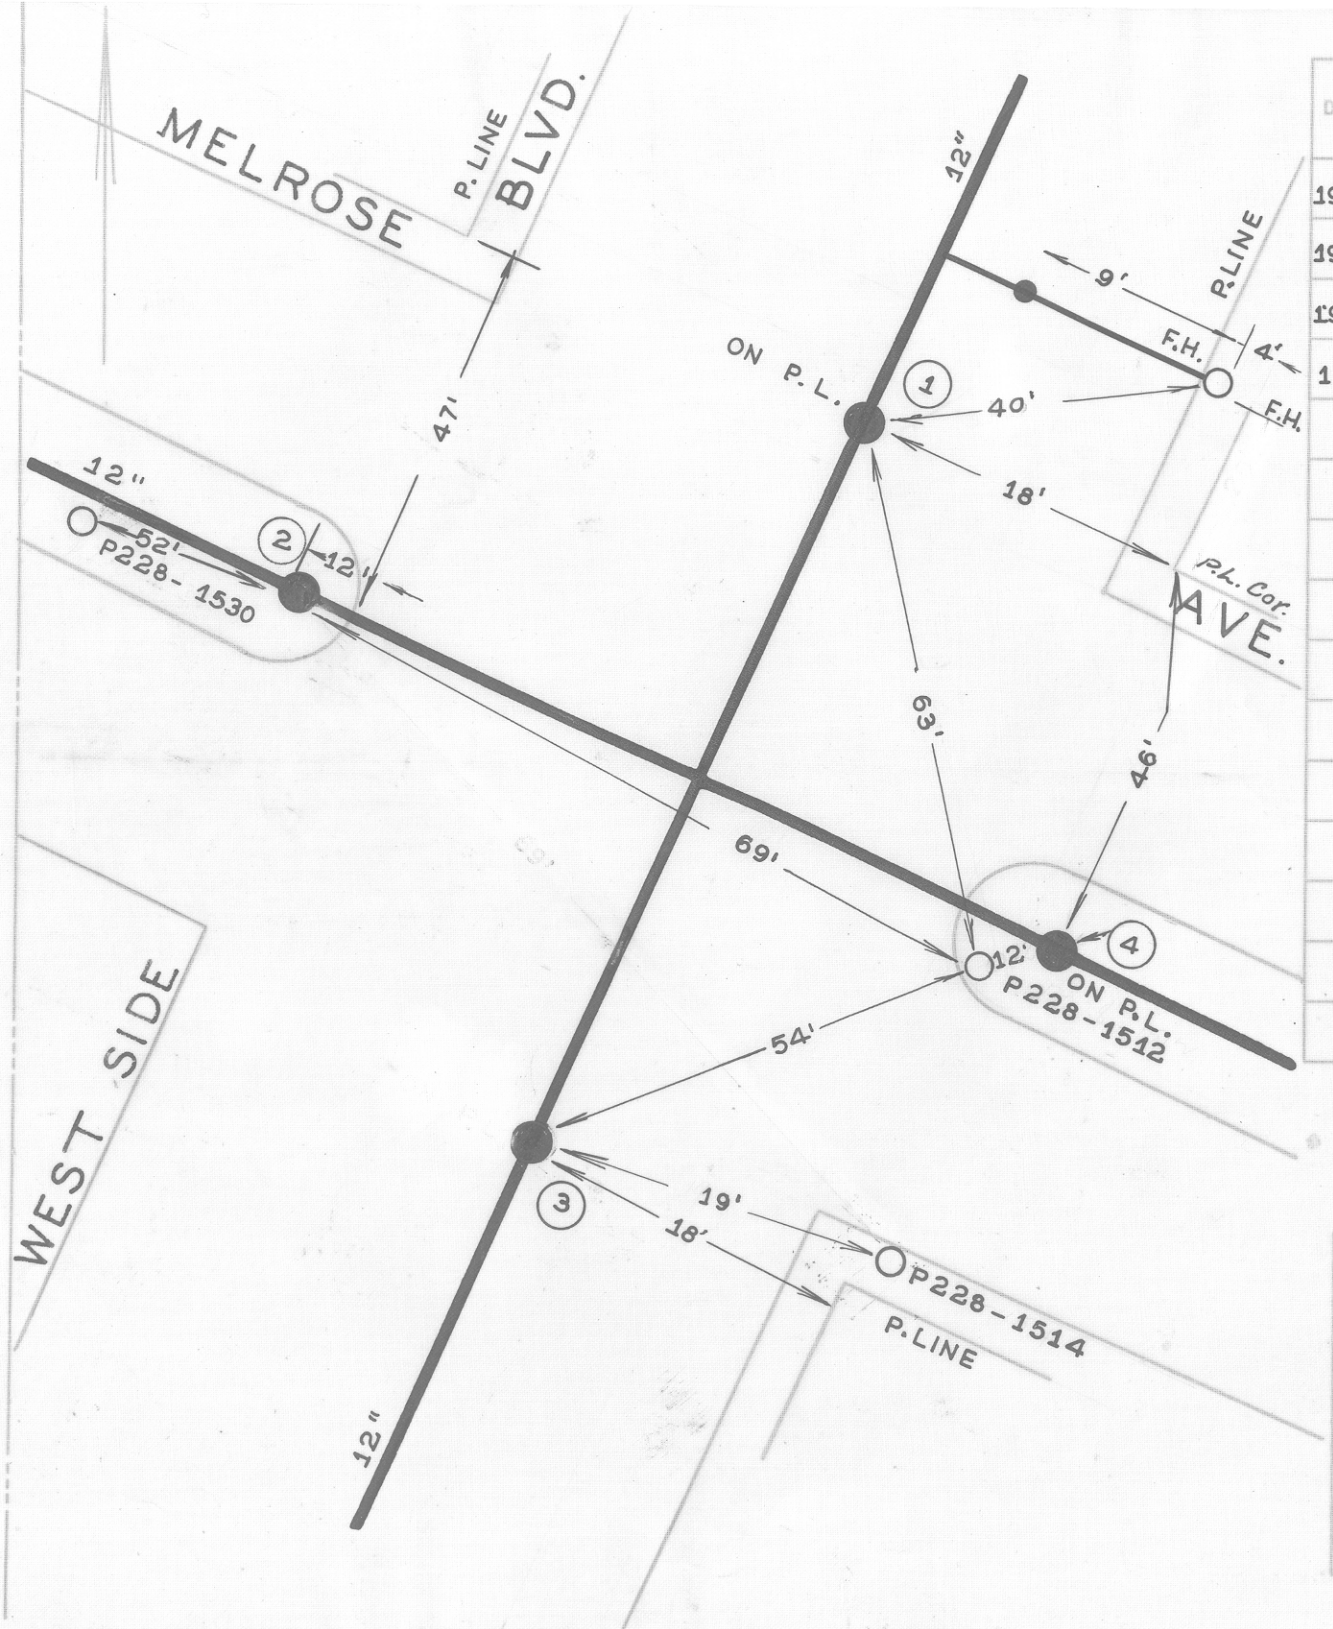

DATE	NO.	SIZE	MAKE	OPEN	TURNS
1950	1	12"	DARLING	R	39
1950	2	12"	DARLING	R	39 1/2
1950	3	12"	DARLING	R	39
1950	4	12"	DARLING	R	39 1/2
	1	0	NPL		
	2	12'-W	WPL		
	3	6'-S	SPL		
	4	0	EPL		

CITY OF ROANOKE—WATER DEP'T

VALVE DIAGRAM

MELROSE AVENUE &

WEST SIDE BOULEVARD

N.W.

SEC. MAP 276

DATE

PAGE NO. NW364