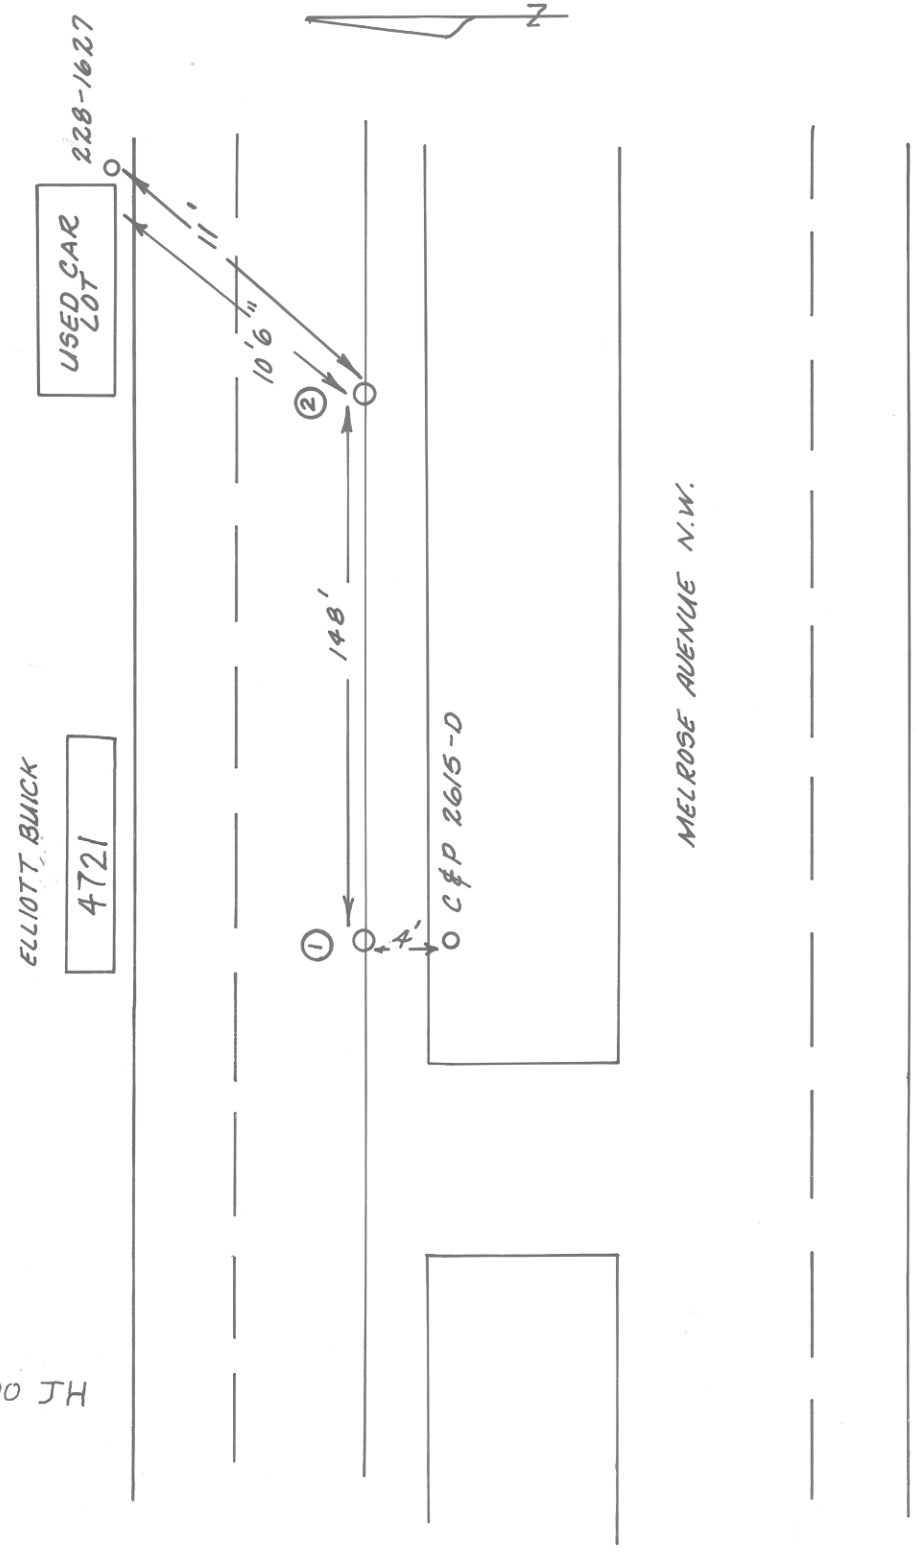

7/2000 JH

DATE	NO.	SIZE	MAKE	OPEN	TURNS
78	1	2"	MISC.	L	7
78	2	2"	MISC.	L	7

CITY OF ROANOKE—WATER DEP'T

VALVE DIAGRAM

4700 BLK. OF MELROSE AVE. N.W.

SEC. MAP 611

DATE PAGE NO.