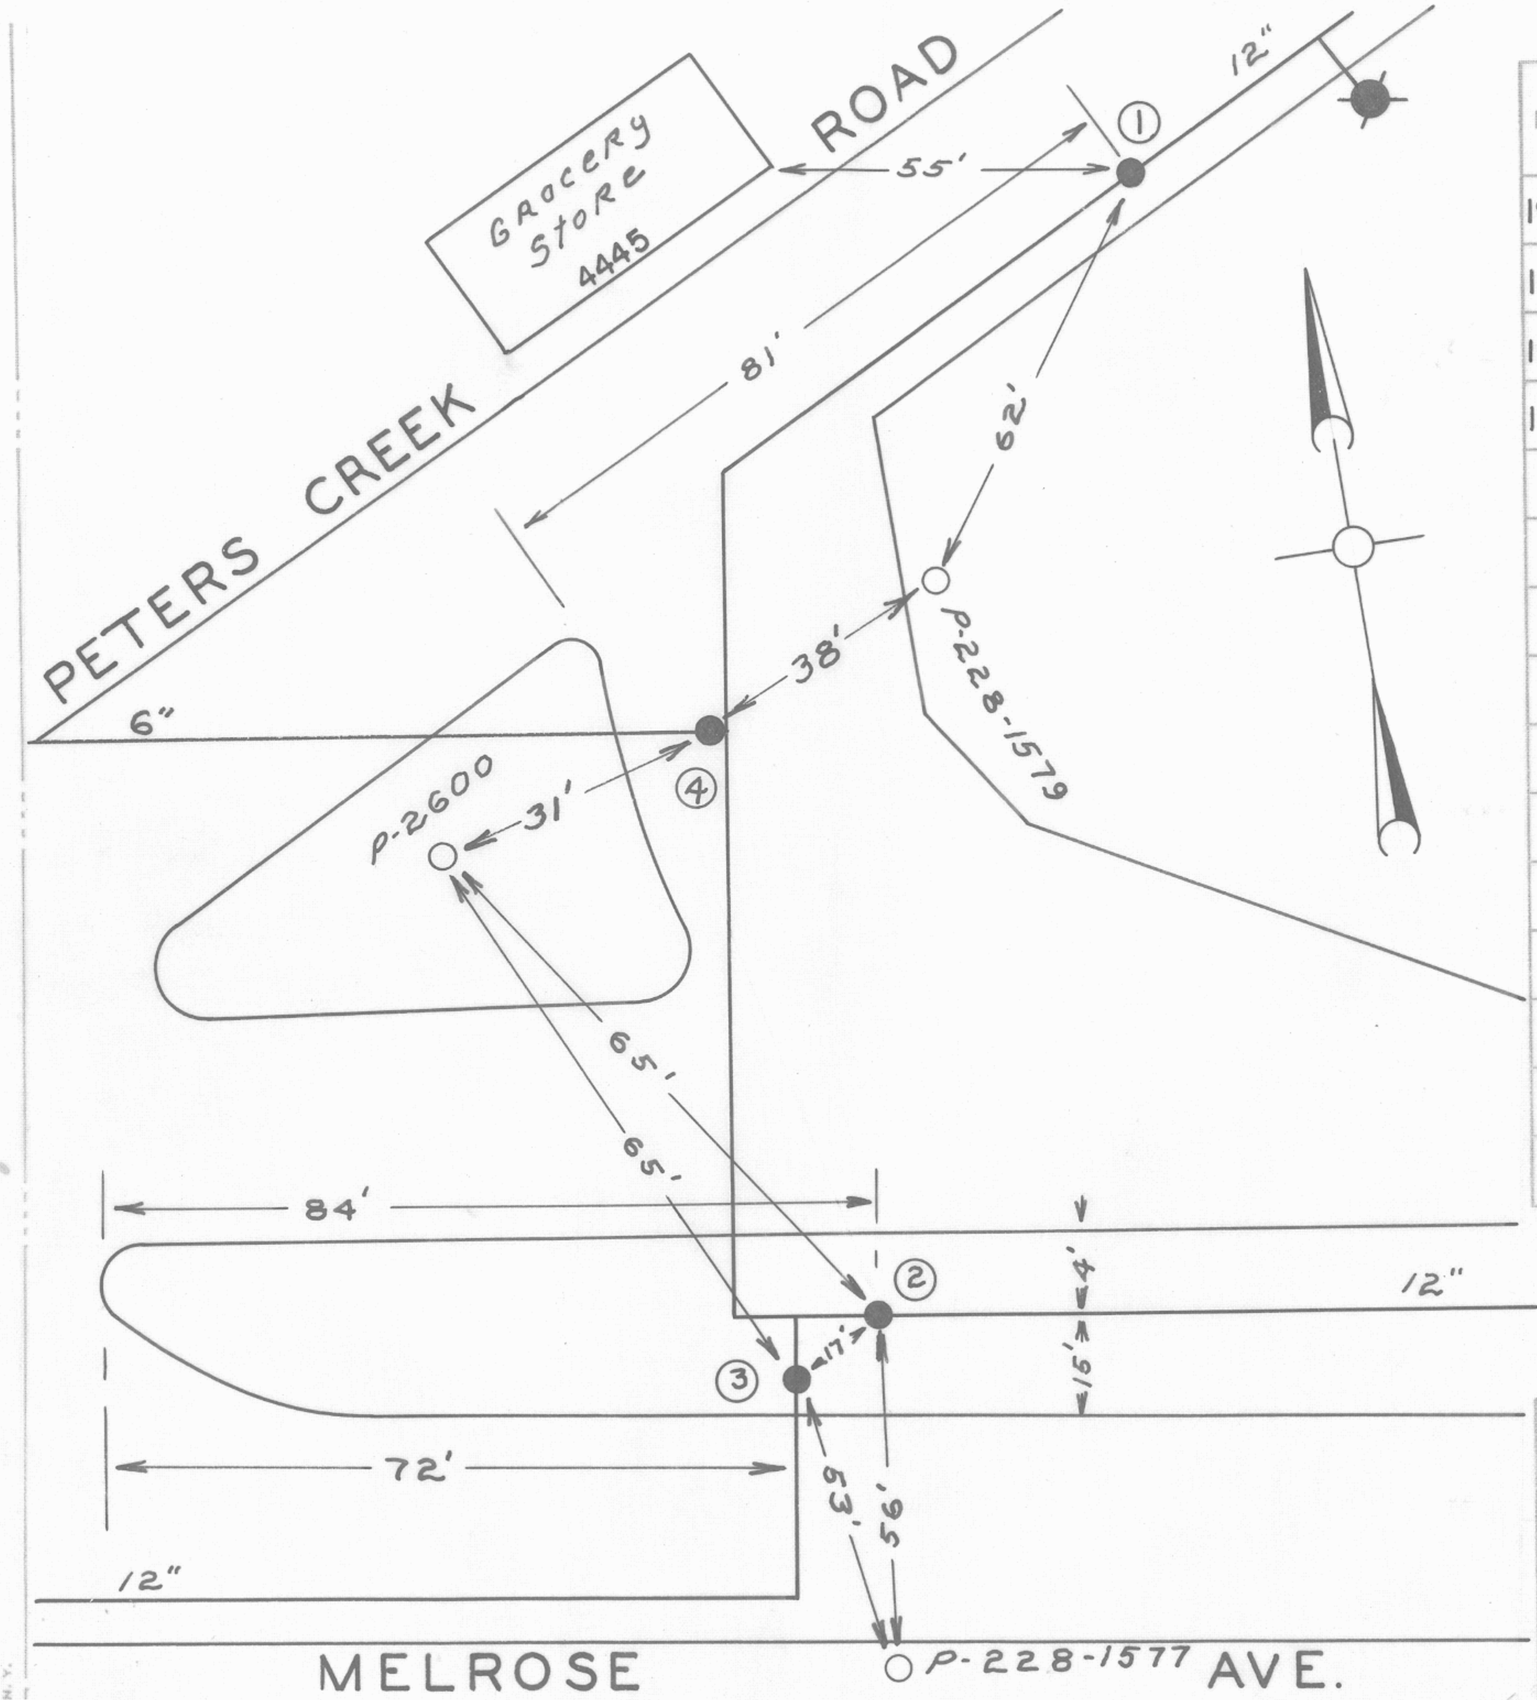

DATE	NO.	SIZE	MAKE	OPEN	TURNS
1950	1	12"	DARLING	R	39
1950	2	12"	DARLING	R	39
1955	3	12"	MUELLER	R	
1957	4	6"	DARLING	R	

CITY OF ROANOKE—WATER DEPT.

VALVE DIAGRAM

MELROSE AVE. &

PETERS CREEK RD. N.W.

SEC. MAP 610

DATE PAGE NO.

"IMPERIAL" TRACING CLOTH K & E CO., N. Y.