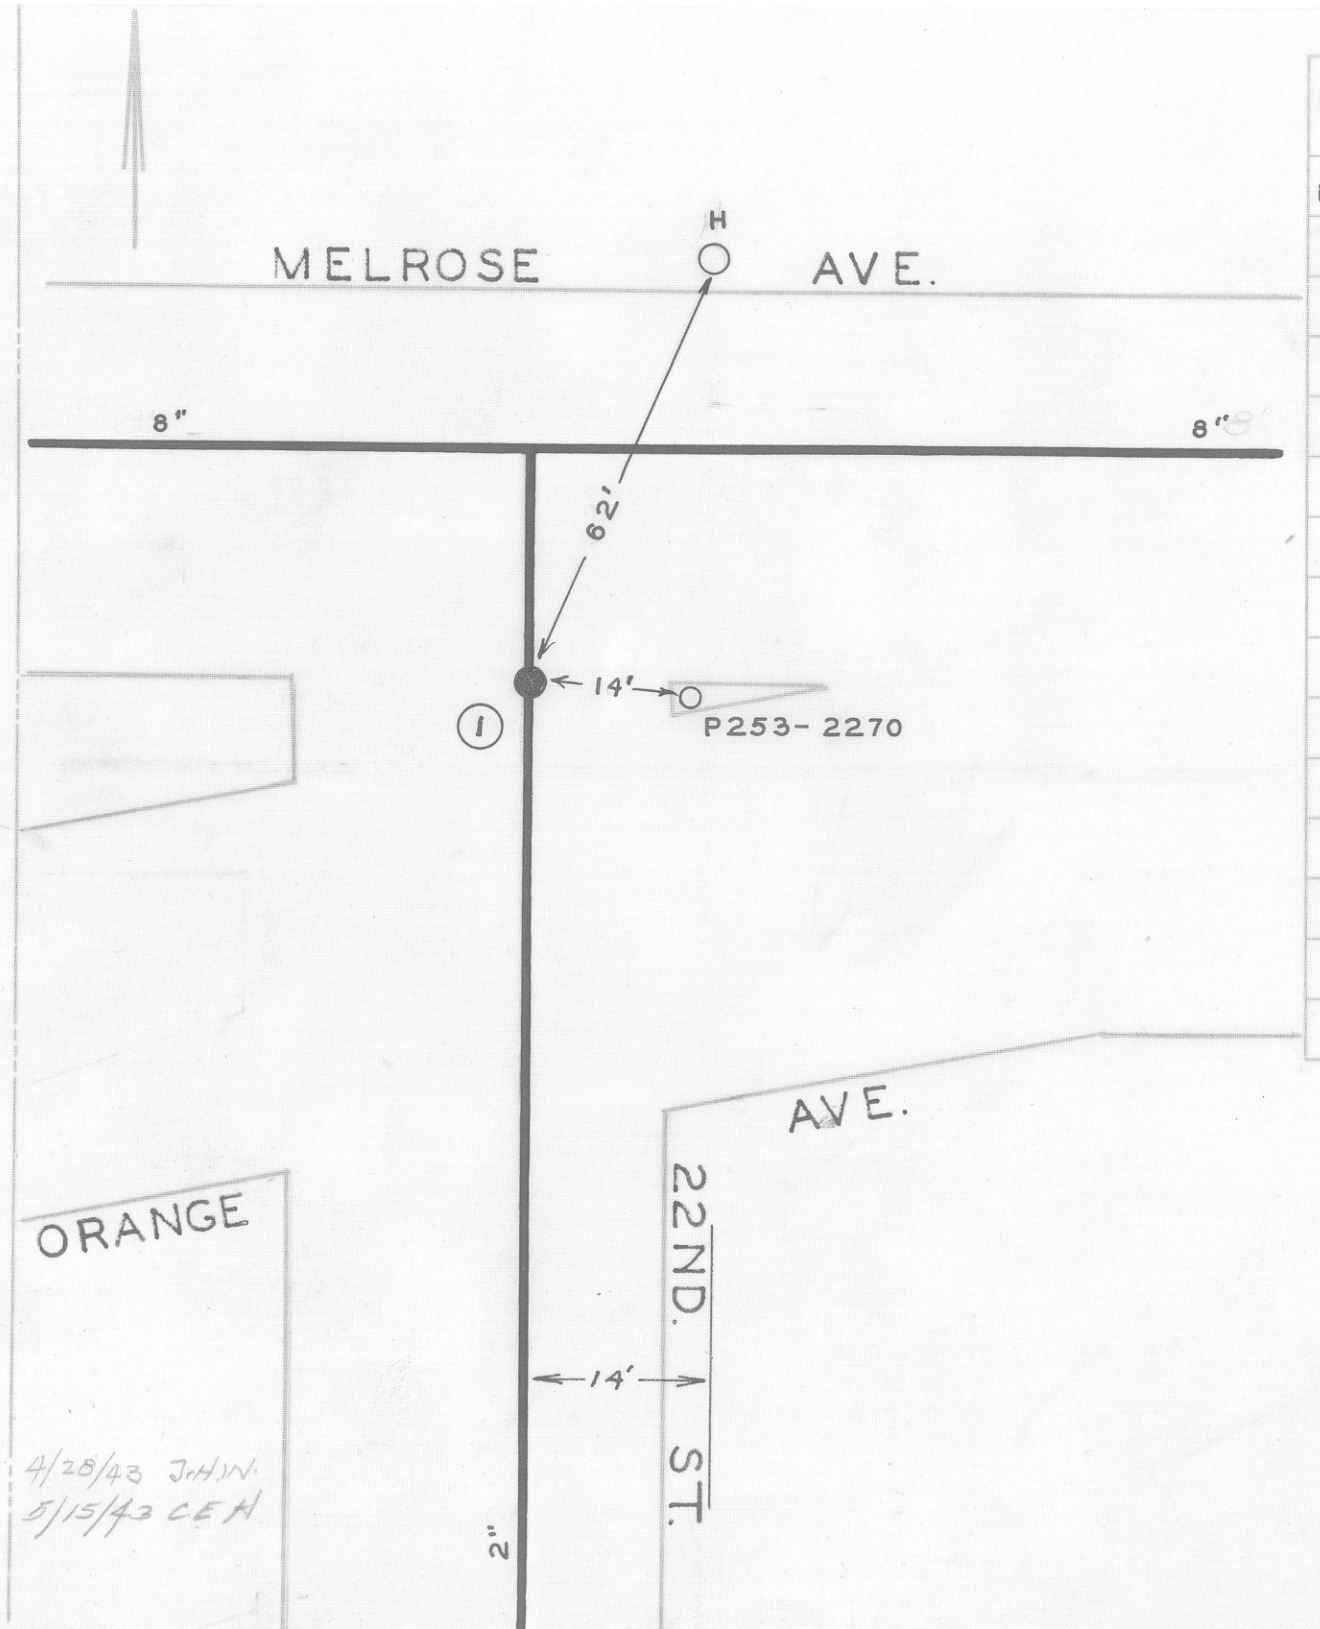

DATE	NO.	SIZE	MAKE	OPEN	TURNS
1916	1	2"		R	5 1/2
	1	11'-N	SPL		

CITY OF ROANOKE—WATER DEP'T

VALVE DIAGRAM

MELROSE AVE. 22ND. ST. & ORANGE AVE. N. W.

SEC. MAP 232

DATE

PAGE NO NW.204