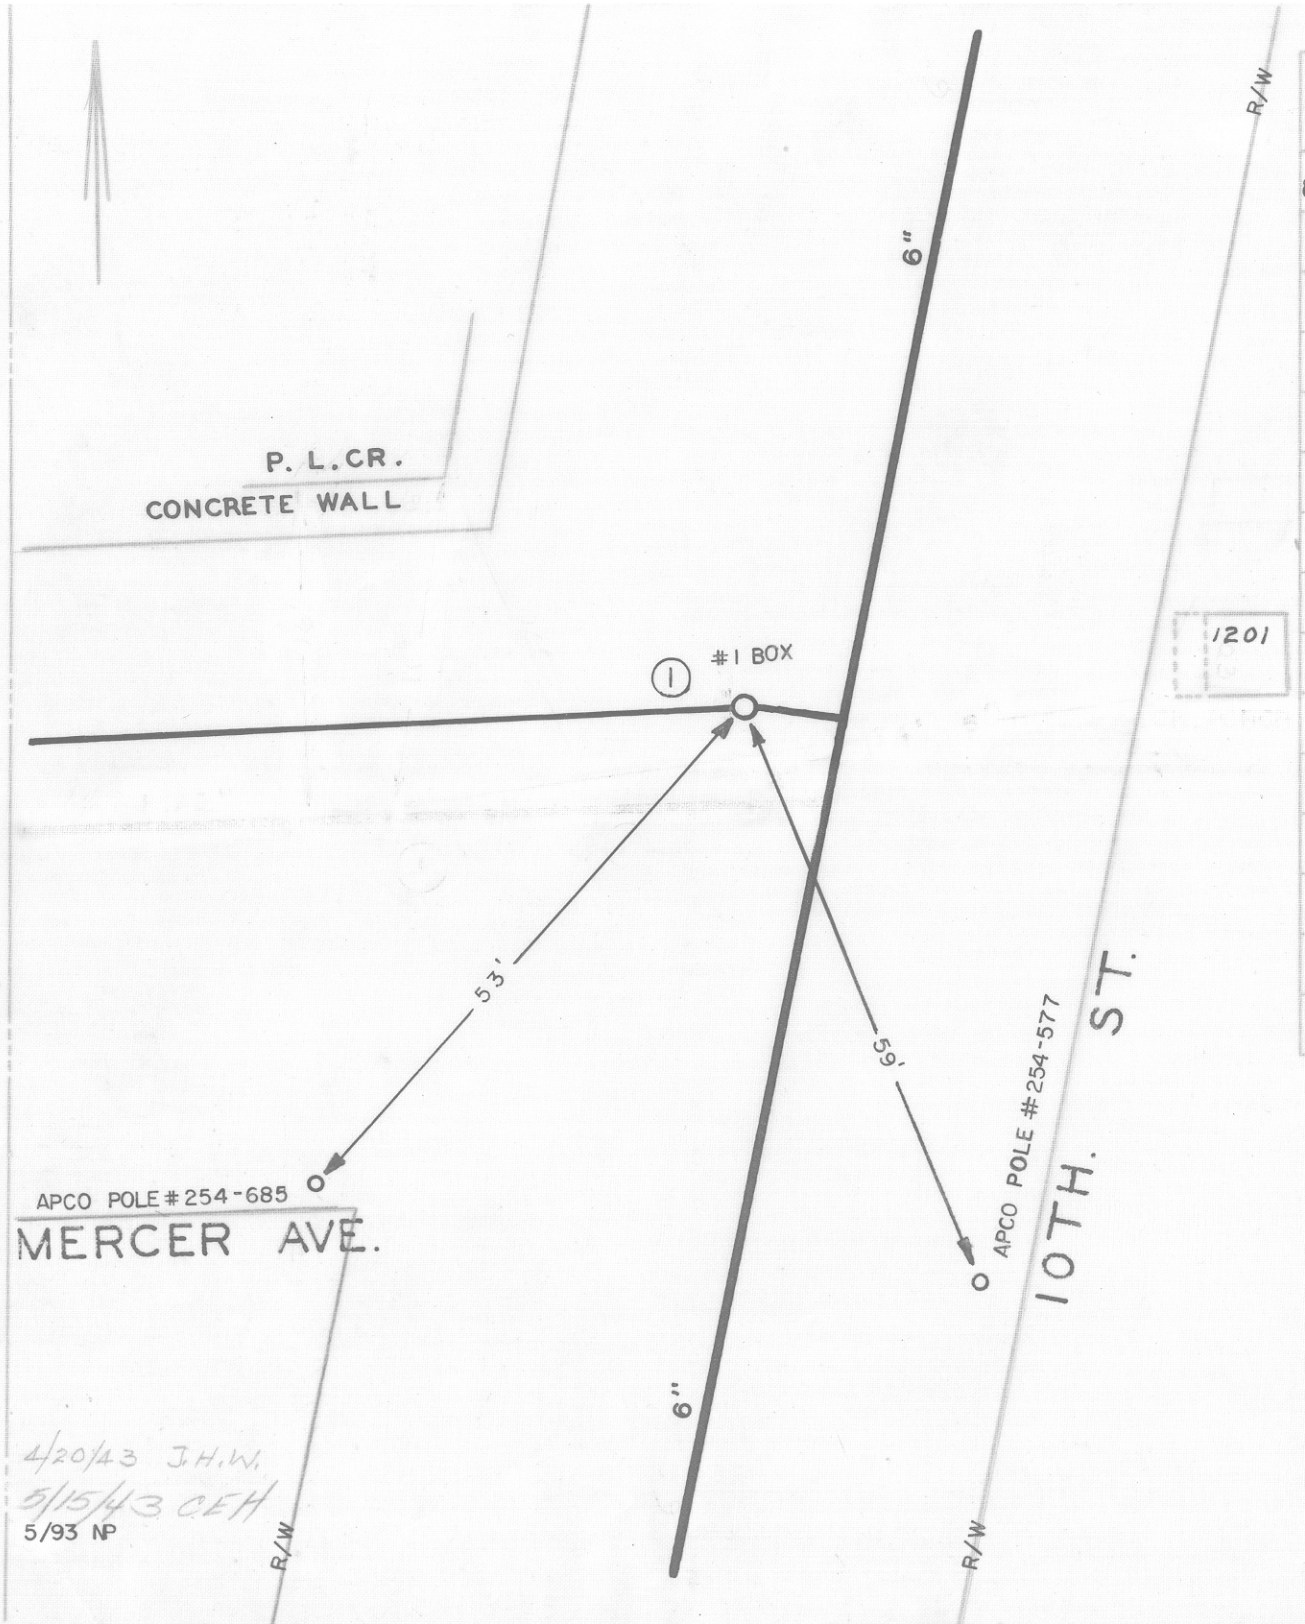

1201

DATE	NO.	SIZE	MAKE	OPEN	TURNS
8-92	1	6"	MUELLER	R	27

CITY OF ROANOKE—WATER DEP'T
VALVE DIAGRAM
MERCER AVE. & 10TH. ST. N. W.

SEC. MAP 223
DATE
PAGE NO. NW.165