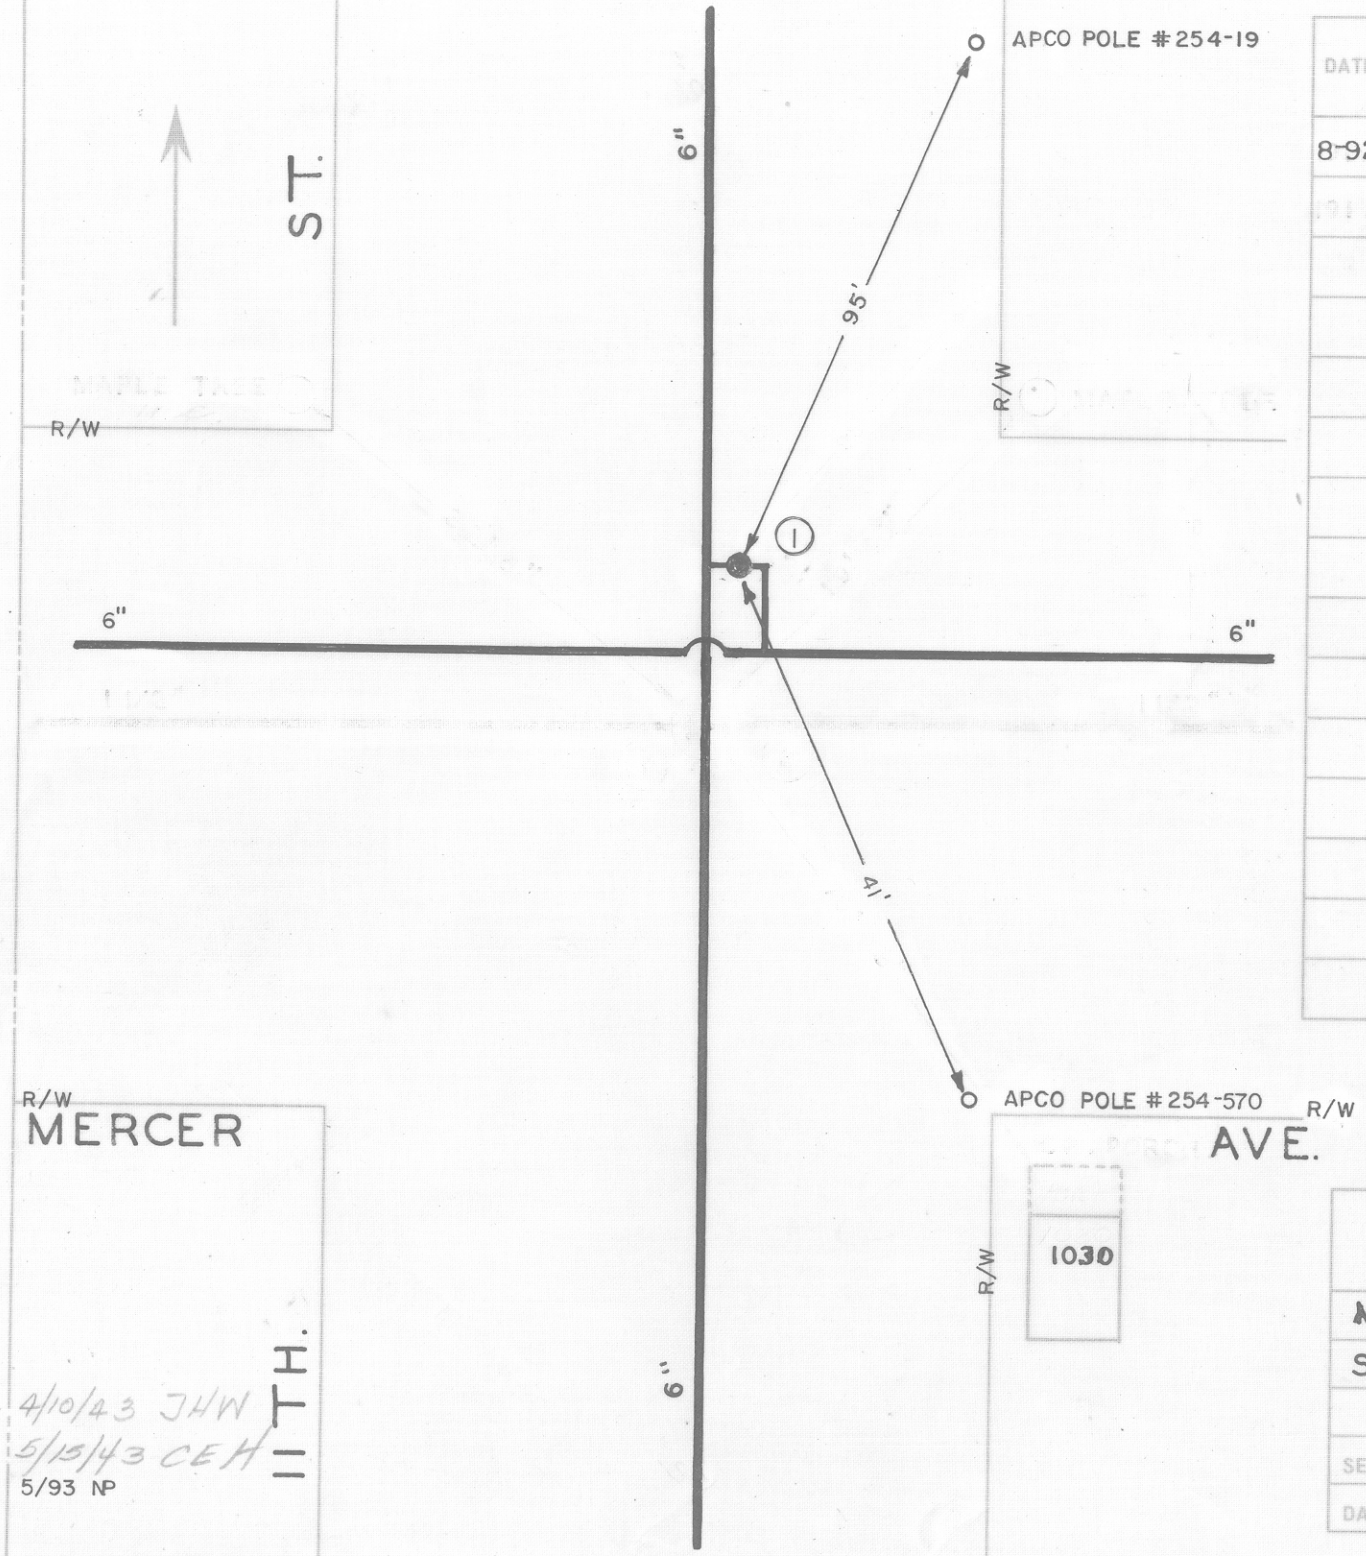

DATE	NO.	SIZE	MAKE	OPEN	TURNS
8-92	1	6"	MUELLER	R	

4/10/43 JHW
5/13/43 CEH
5/93 NP

CITY OF ROANOKE—WATER DEP'T
VALVE DIAGRAM
MERCER AVE. & 11TH. ST. N.W.

SEC. MAP 223

DATE

PAGE NO NW.166