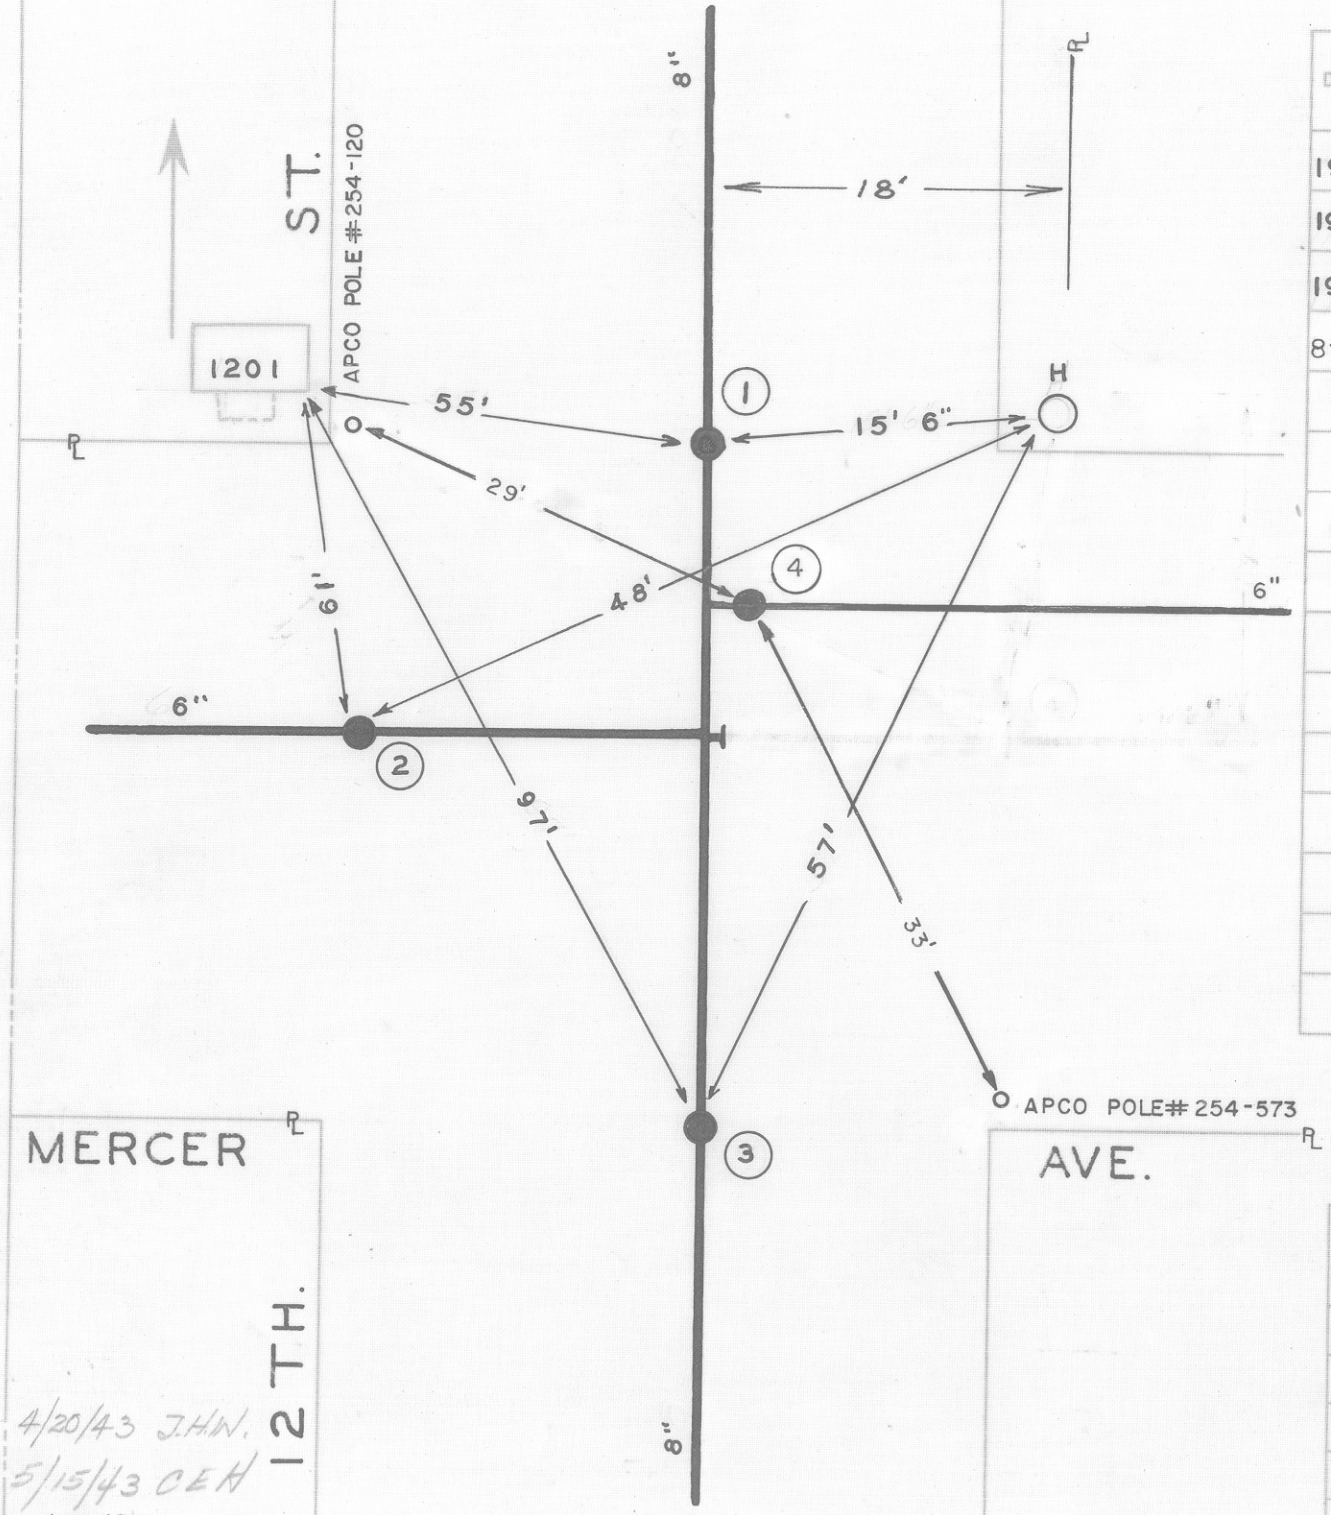


| DATE | NO. | SIZE | MAKE | OPEN | TURNS |
|---|---|---|---|---|---|
| 1939 | 1 | 8" | | R | 27 |
| 1939 | 2 | 6" | | R | 20 1/2 |
| 1939 | 3 | 8" | | R | 27 |
| 8-92 | 4 | 6" | MUELLER | R | |
| | | | | | |
| | | | | | |
| | | | | | |
| | | | | | |
| | | | | | |
| | | | | | |
| | | | | | |
| | 1 | 0 | NPL | | |
| | 2 | 0 | WPL | | |
| | 3 | 0 | SPL | | |
| | | | | | |

4/20/43 J.H.W.
5/15/43 CEH
5/93 NP

CITY OF ROANOKE—WATER DEP'T
VALVE DIAGRAM
MERCER AVE. & 12TH. ST. N.W.

SEC. MAP 223

DATE

PAGE NO. NW 167