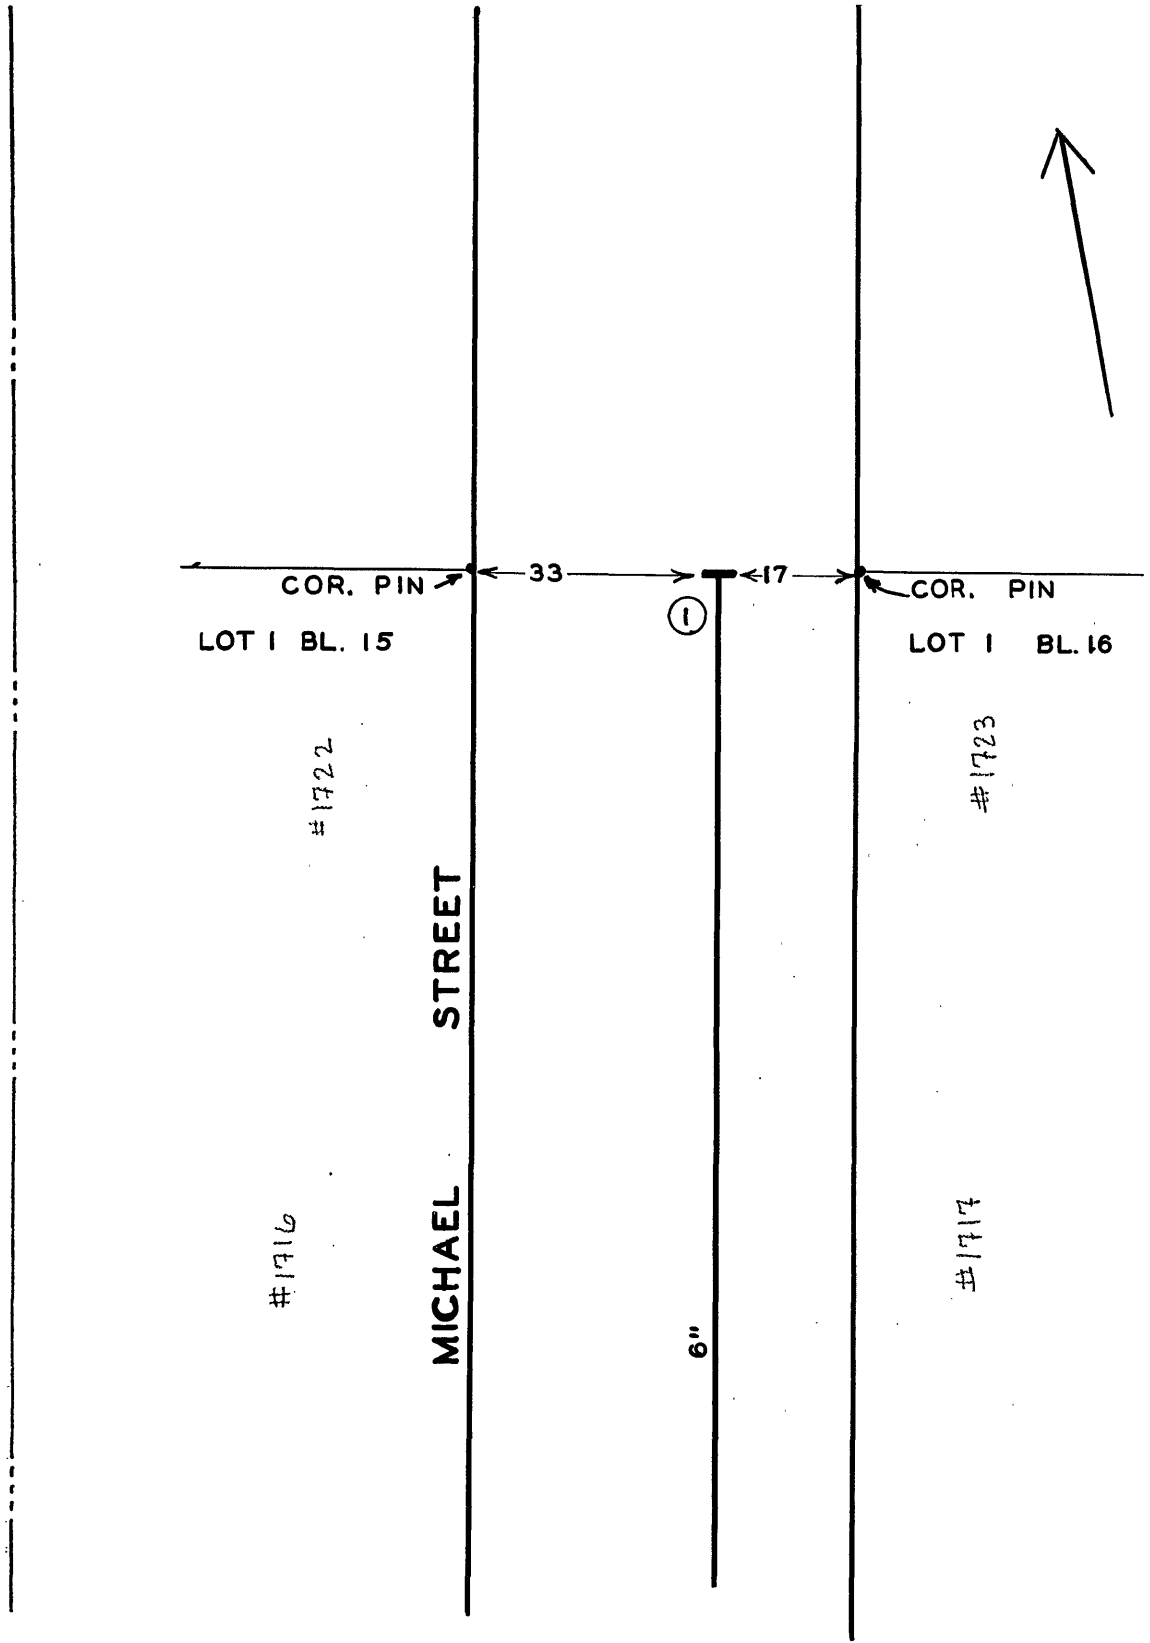

DATE	NO.	SIZE	MAKE	OPEN	TURNS
12-62	1	2	MISC.		

CITY OF ROANOKE—WATER DEPT.

VALVE DIAGRAM

MICHAEL STREET 330± N.

OF HARVEST LANE N.W.

SEC. MAP 4 6e38 N.W.

DATE PAGE NO.