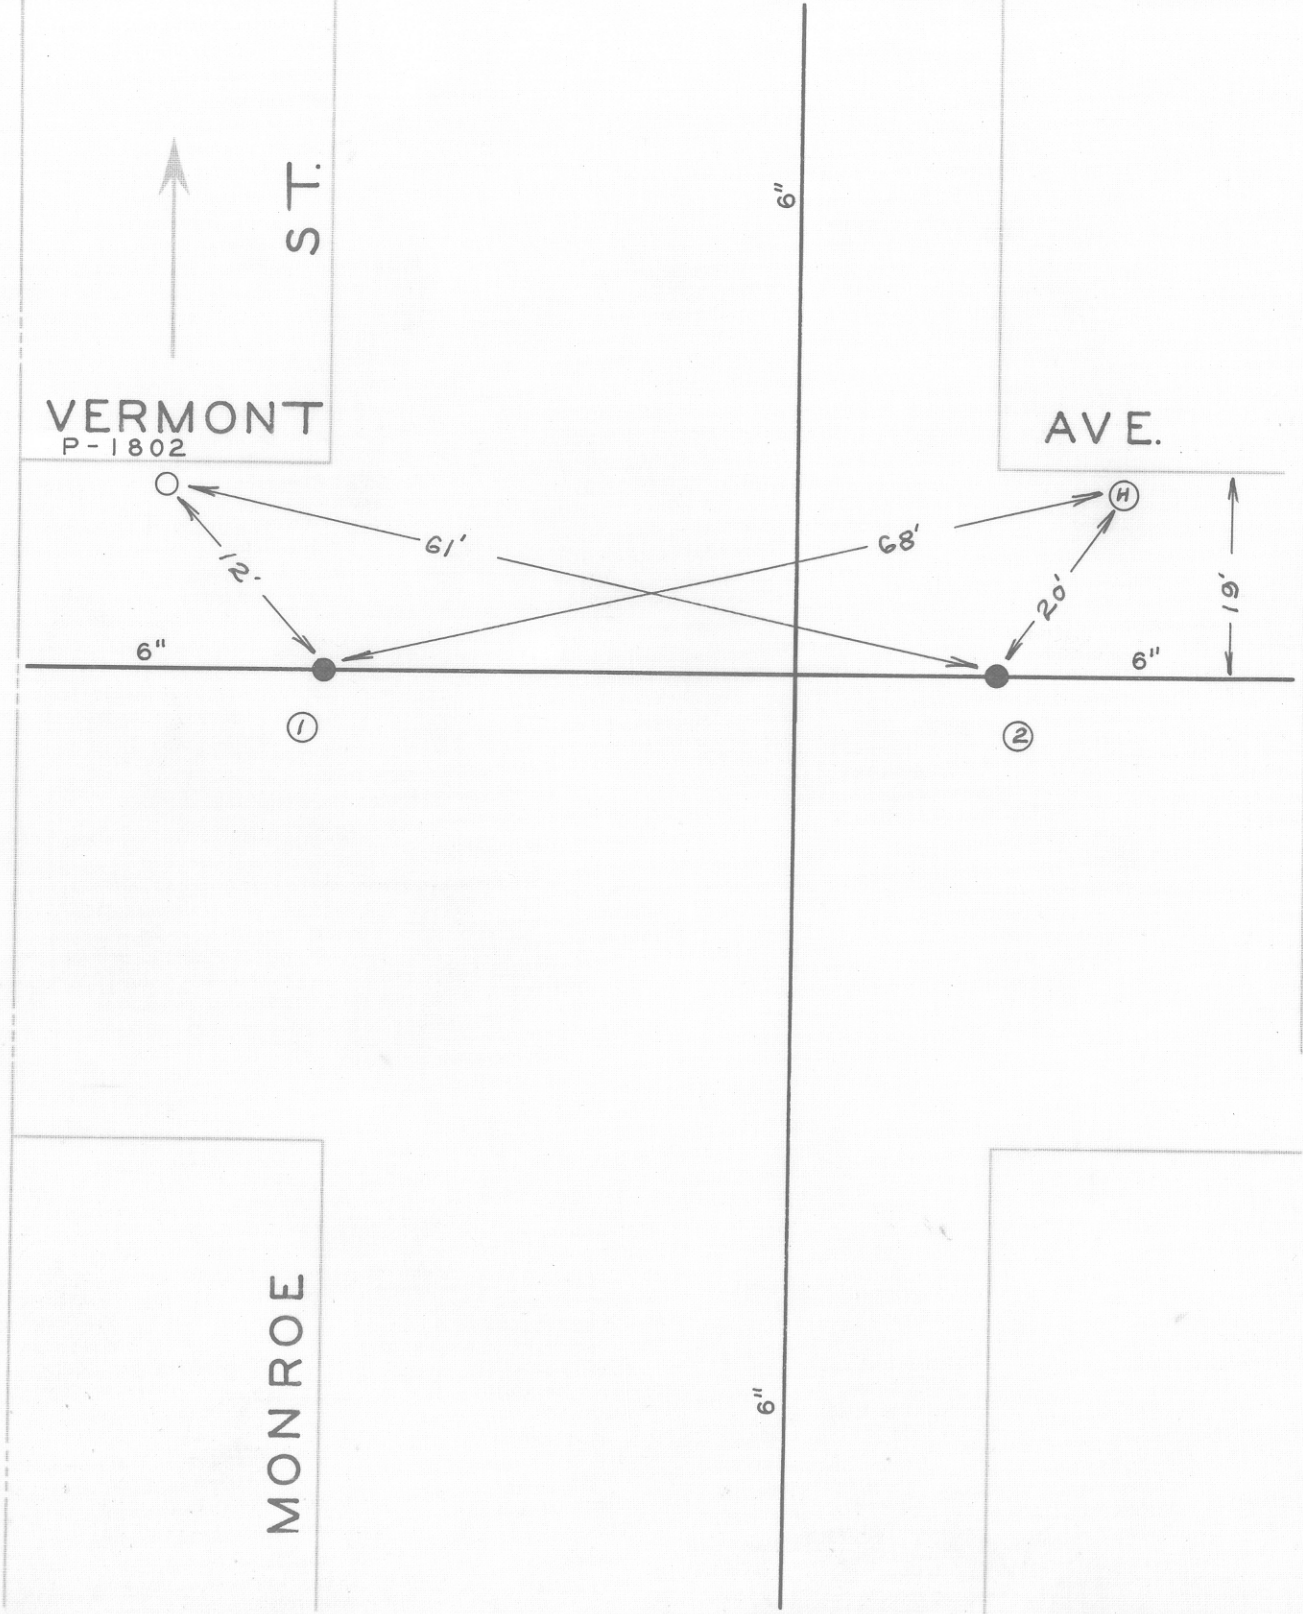

DATE	NO.	SIZE	MAKE	OPEN	TURNS
	1	6"	MUELLER	R	20
	2	6"	MUELLER	R	20
	1	0	WPL		
	2	0	EPL		

CITY OF ROANOKE—WATER DEP'T

VALVE DIAGRAM

MONROE ST. & VERMONT AVENUE N. W.

SEC. MAP 276

DATE PAGE NO.