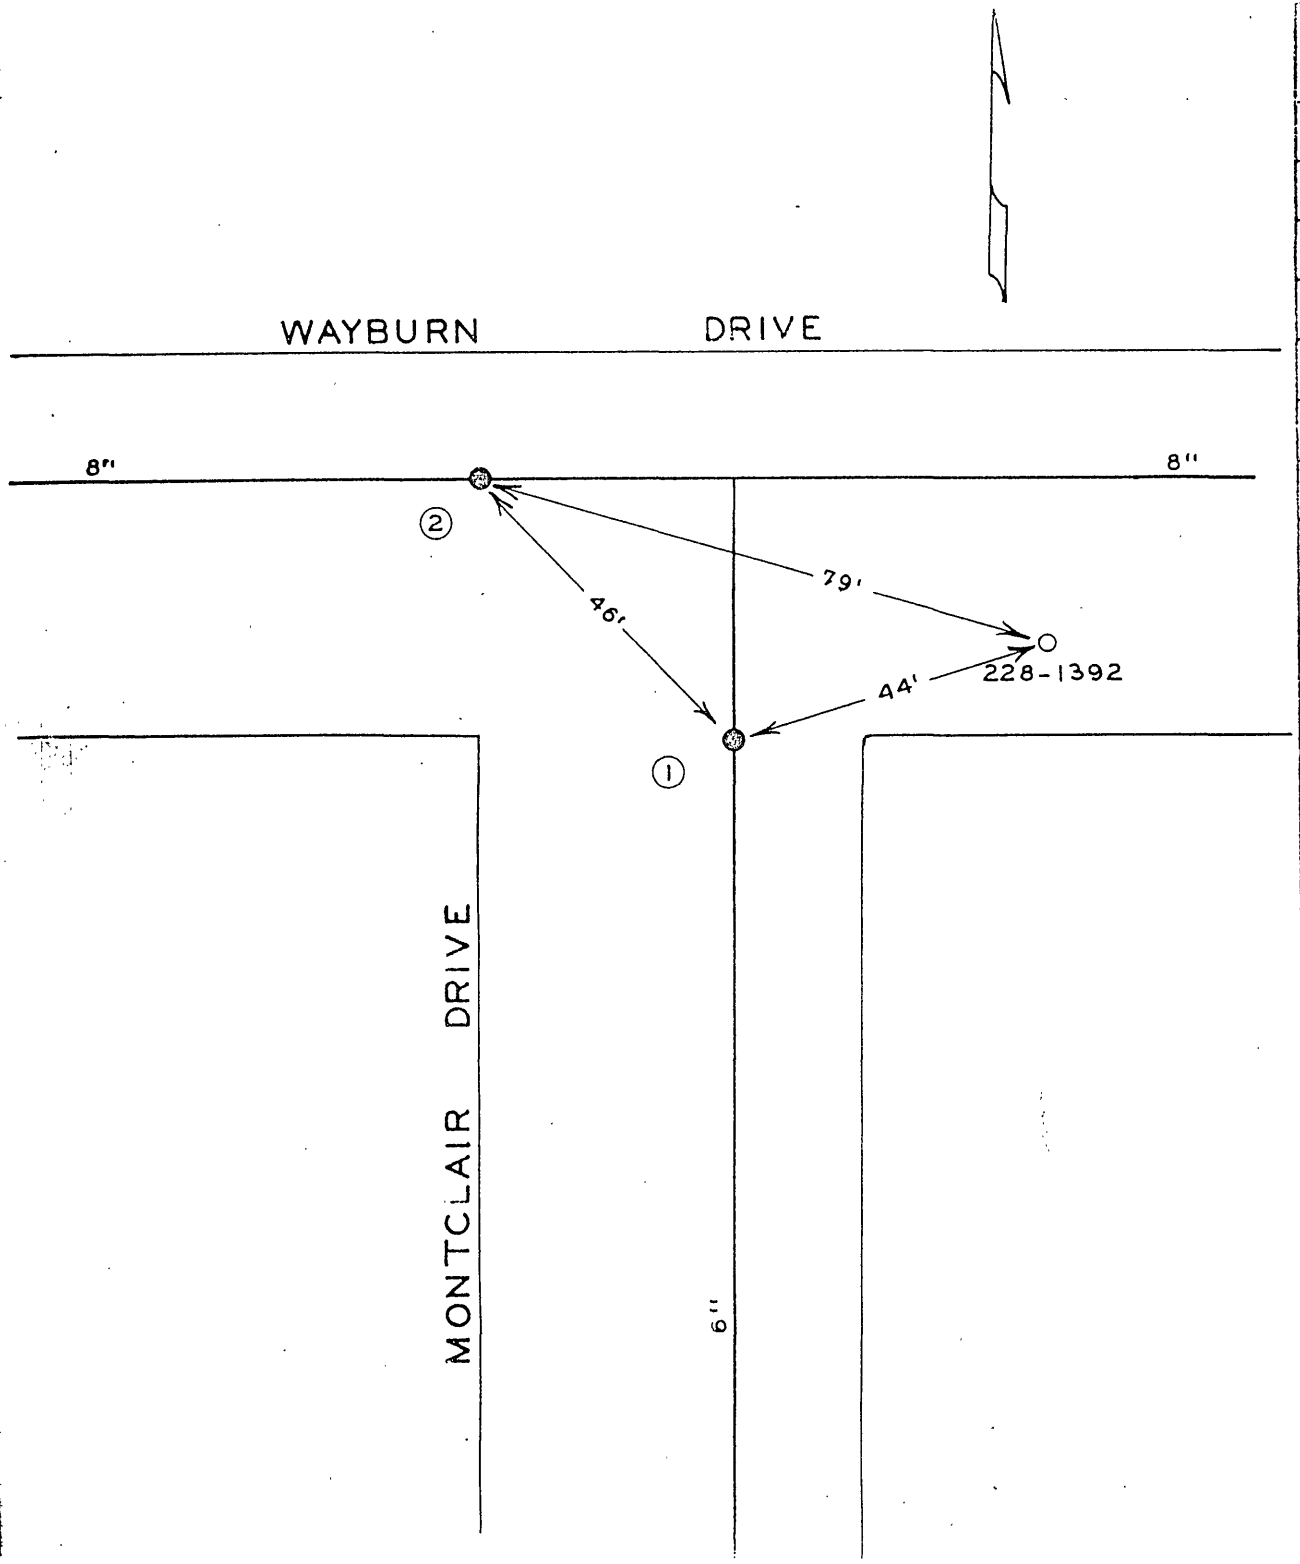

DATE	NO.	SIZE	MAKE	OPEN	TURNS
11-64	1	6	DARLING	R	21
11-64	2	8	DARLING	R	27
	1	0	SPL		
	2	0	WPL		

CITY OF ROANOKE—WATER DEPT.

VALVE DIAGRAM

MONTCLAIR DRIVE &

WAYBURN DRIVE N.W.

SEC. MAP 47 Roanoke County

DATE DEC 8 1965 PAGE NO.