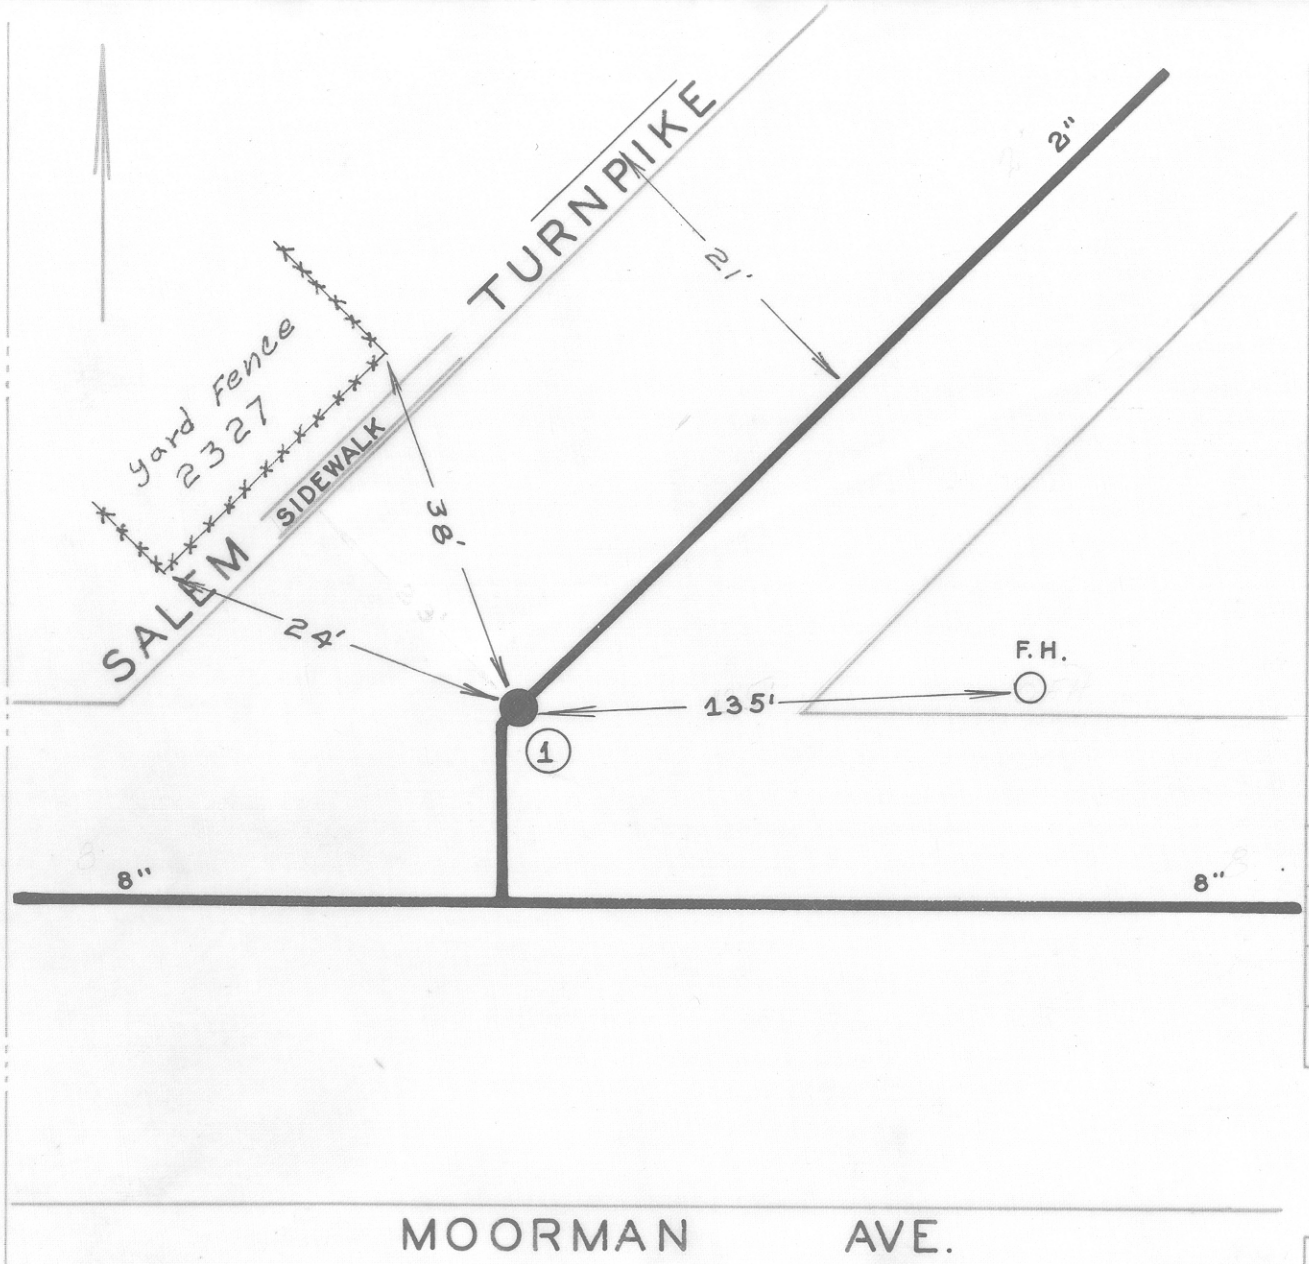

DATE	NO.	SIZE	MAKE	OPEN	TURNS
1951	1	2"	DARLING	R	7
	1	0	NPL MOORMAN		

CITY OF ROANOKE — WATER DEPT.

VALVE DIAGRAM

MOORMAN AVENUE &

LYNCHBURG SALEM

TURNPIKE N.W.

SEC. MAP 232

DATE 4/30/51 PAGE NO. N.W.370

"IMPERIAL" TRACING CLOTH K & E CO., N. Y.