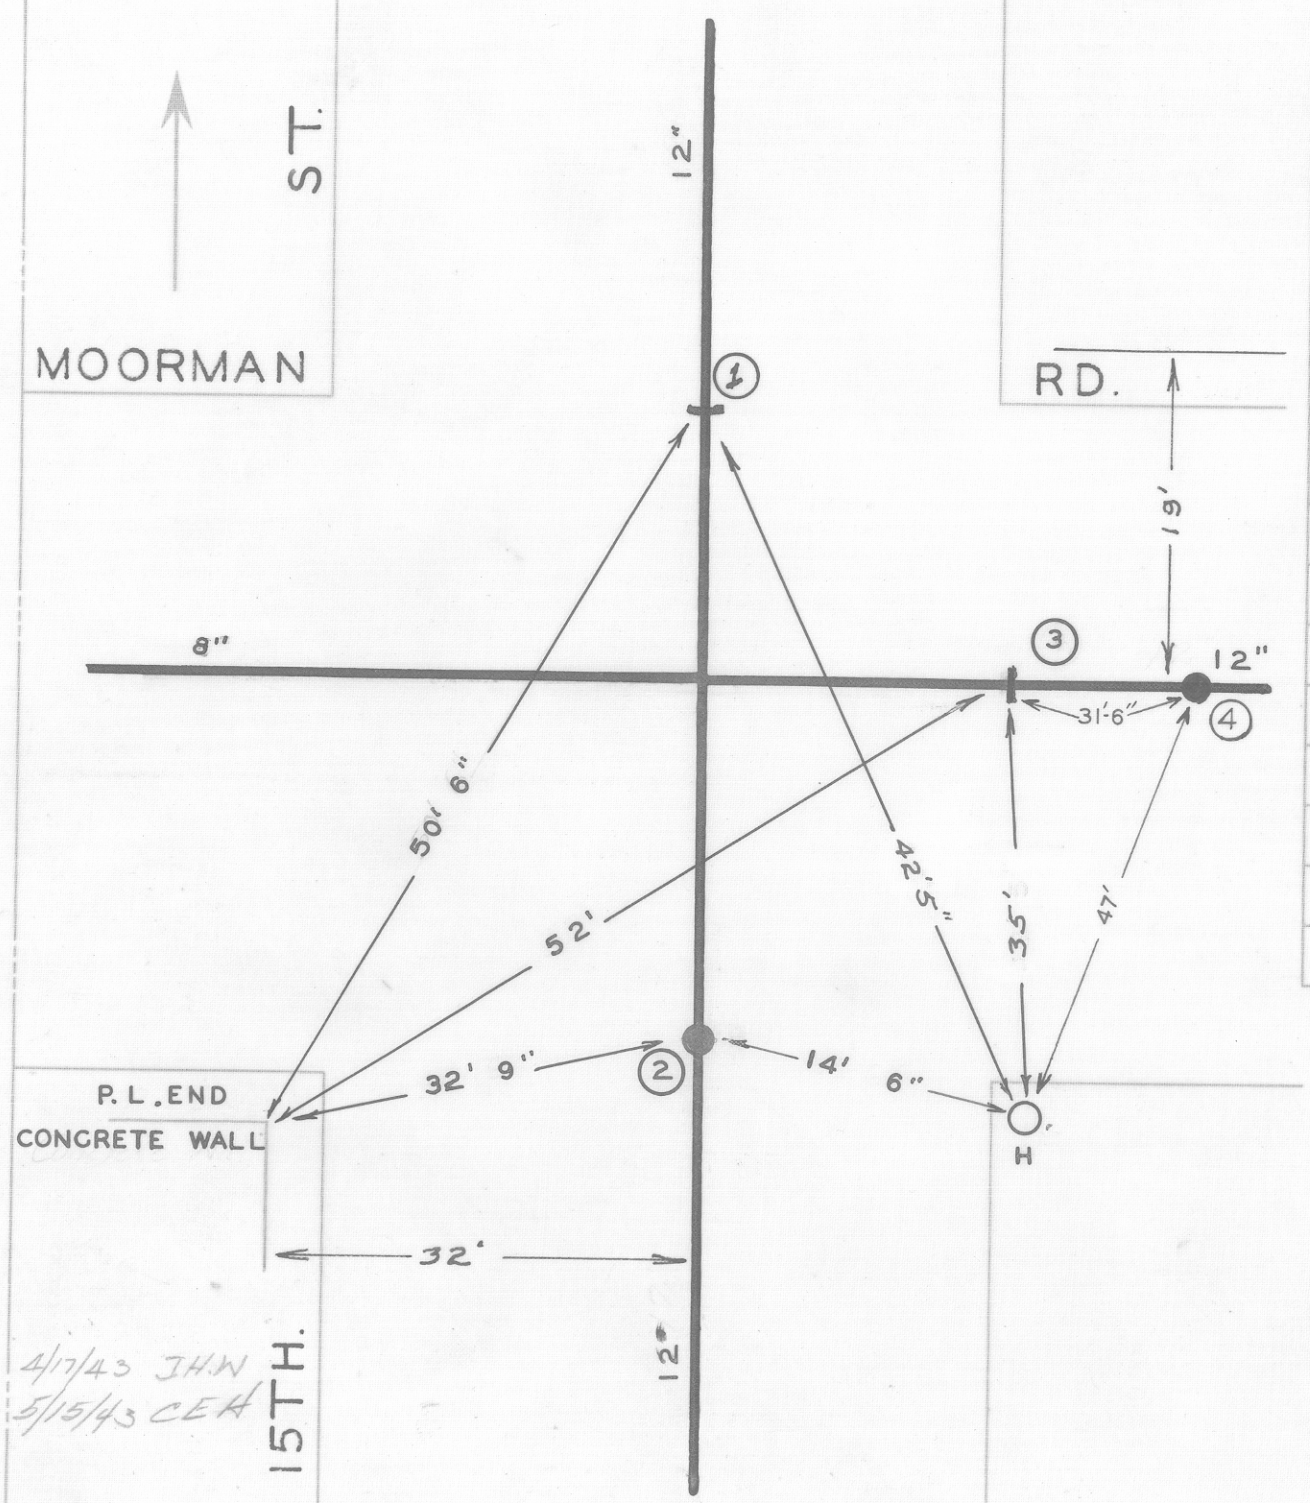

DATE	NO.	SIZE	MAKE	OPEN	TURNS
1923	1	12"		R	38
1923	2	12"		R	38 1/2
1925	3	12"		R	39
1967	4	1"	PITOT STATION		
	1	13'-S	NPL		
	2	7'-N	SPL		
	3	10'-W	EPL		

CITY OF ROANOKE—WATER DEP'T

VALVE DIAGRAM

MOORMAN ROAD & 15 TH. ST. N. W.

SEC. MAP 221.

DATE

PAGE NO. N.W. 135