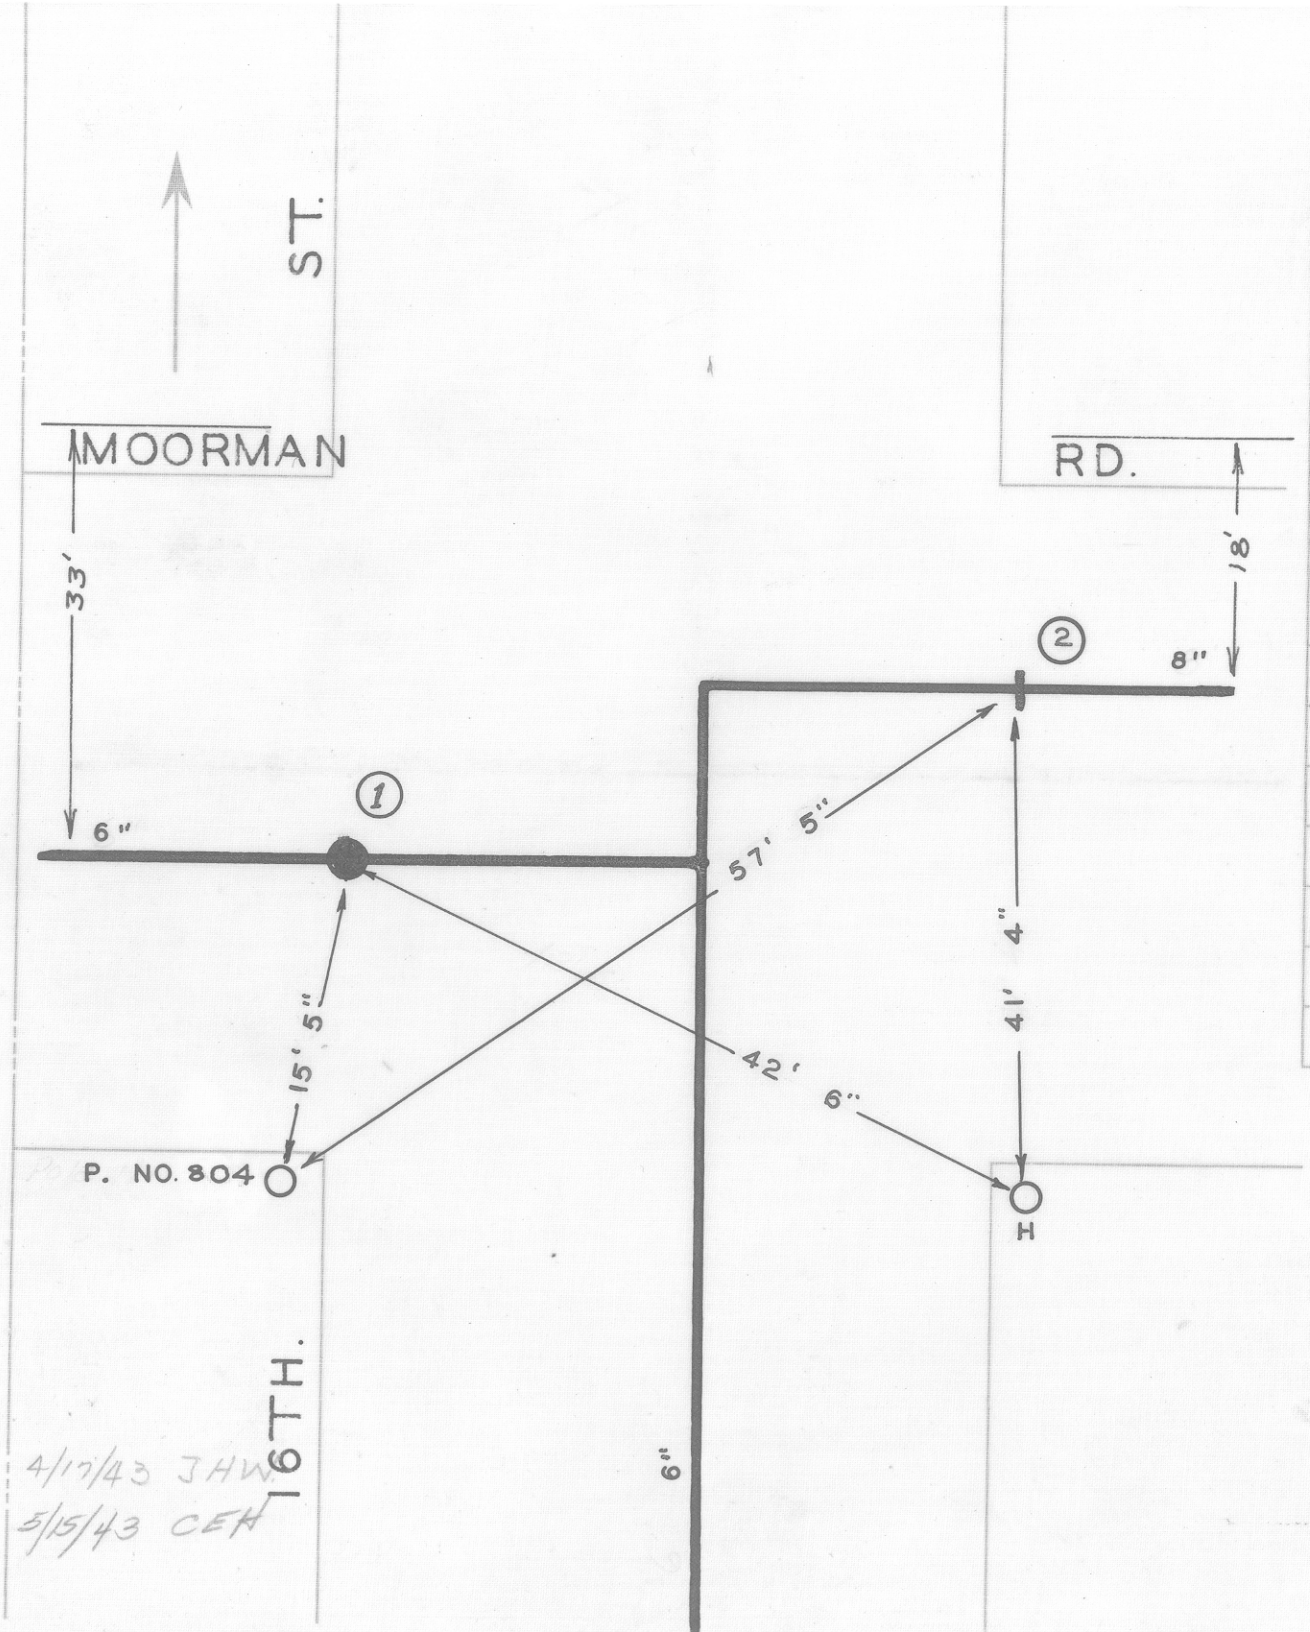

DATE	NO.	SIZE	MAKE	OPEN	TURNS
1905	1	6"		R	13 1/2
1931	2	8"		R	17
	1	7' E	WPL		
	2	0	EPL		

CITY OF ROANOKE—WATER DEP'T

VALVE DIAGRAM

MOORMAN ROAD & 16TH. ST. N. W.

SEC. MAP 221

DATE

PAGE NO. NW 136