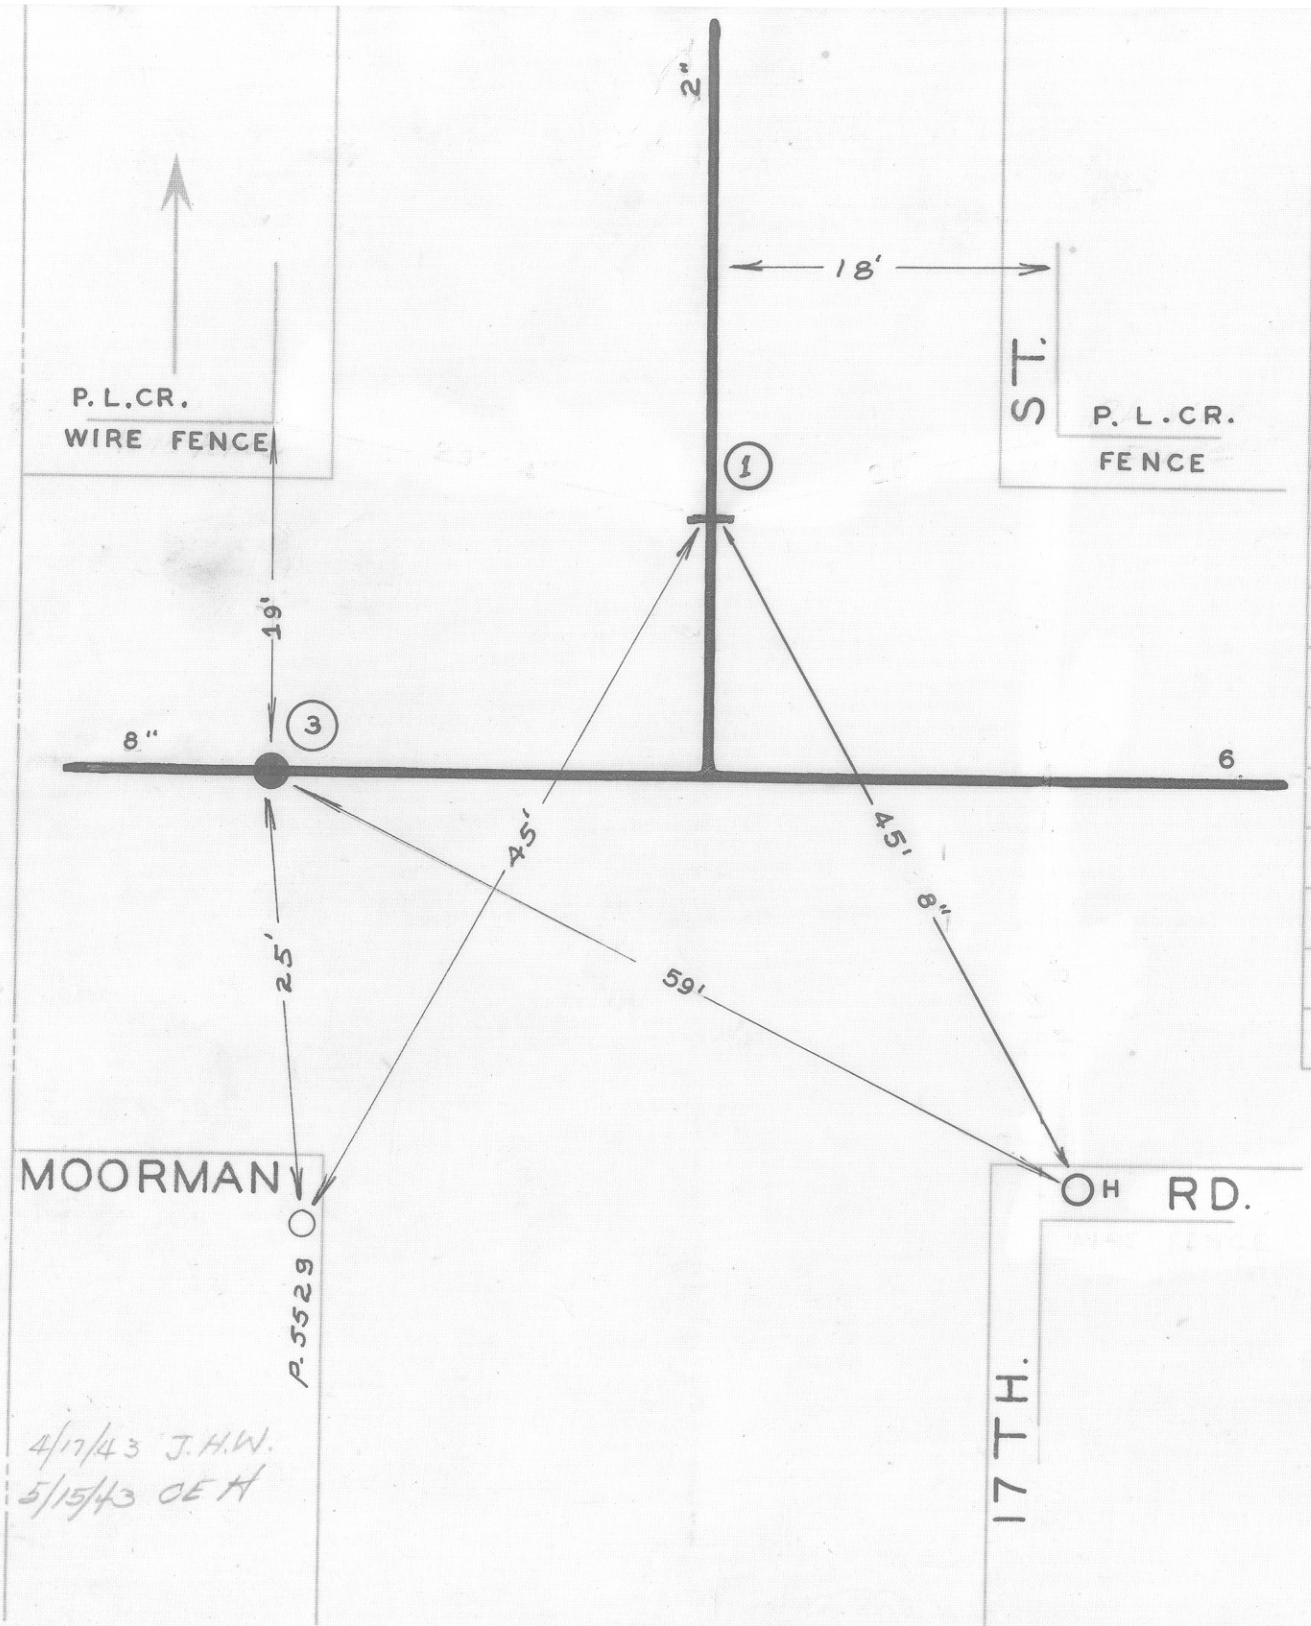

DATE	NO.	SIZE	MAKE	OPEN	TURNS
1923	1	2"		R	7
1931	2	ABANDONDED			
1951	3	8"	DARLING	R	27
	1	3'-S	NPL		
	3	0	WPL		

CITY OF ROANOKE—WATER DEP'T

VALVE DIAGRAM

MOORMAN ROAD & 17TH. ST. N. W.

SEC. MAP 221

DATE

PAGE NO. N.W.137