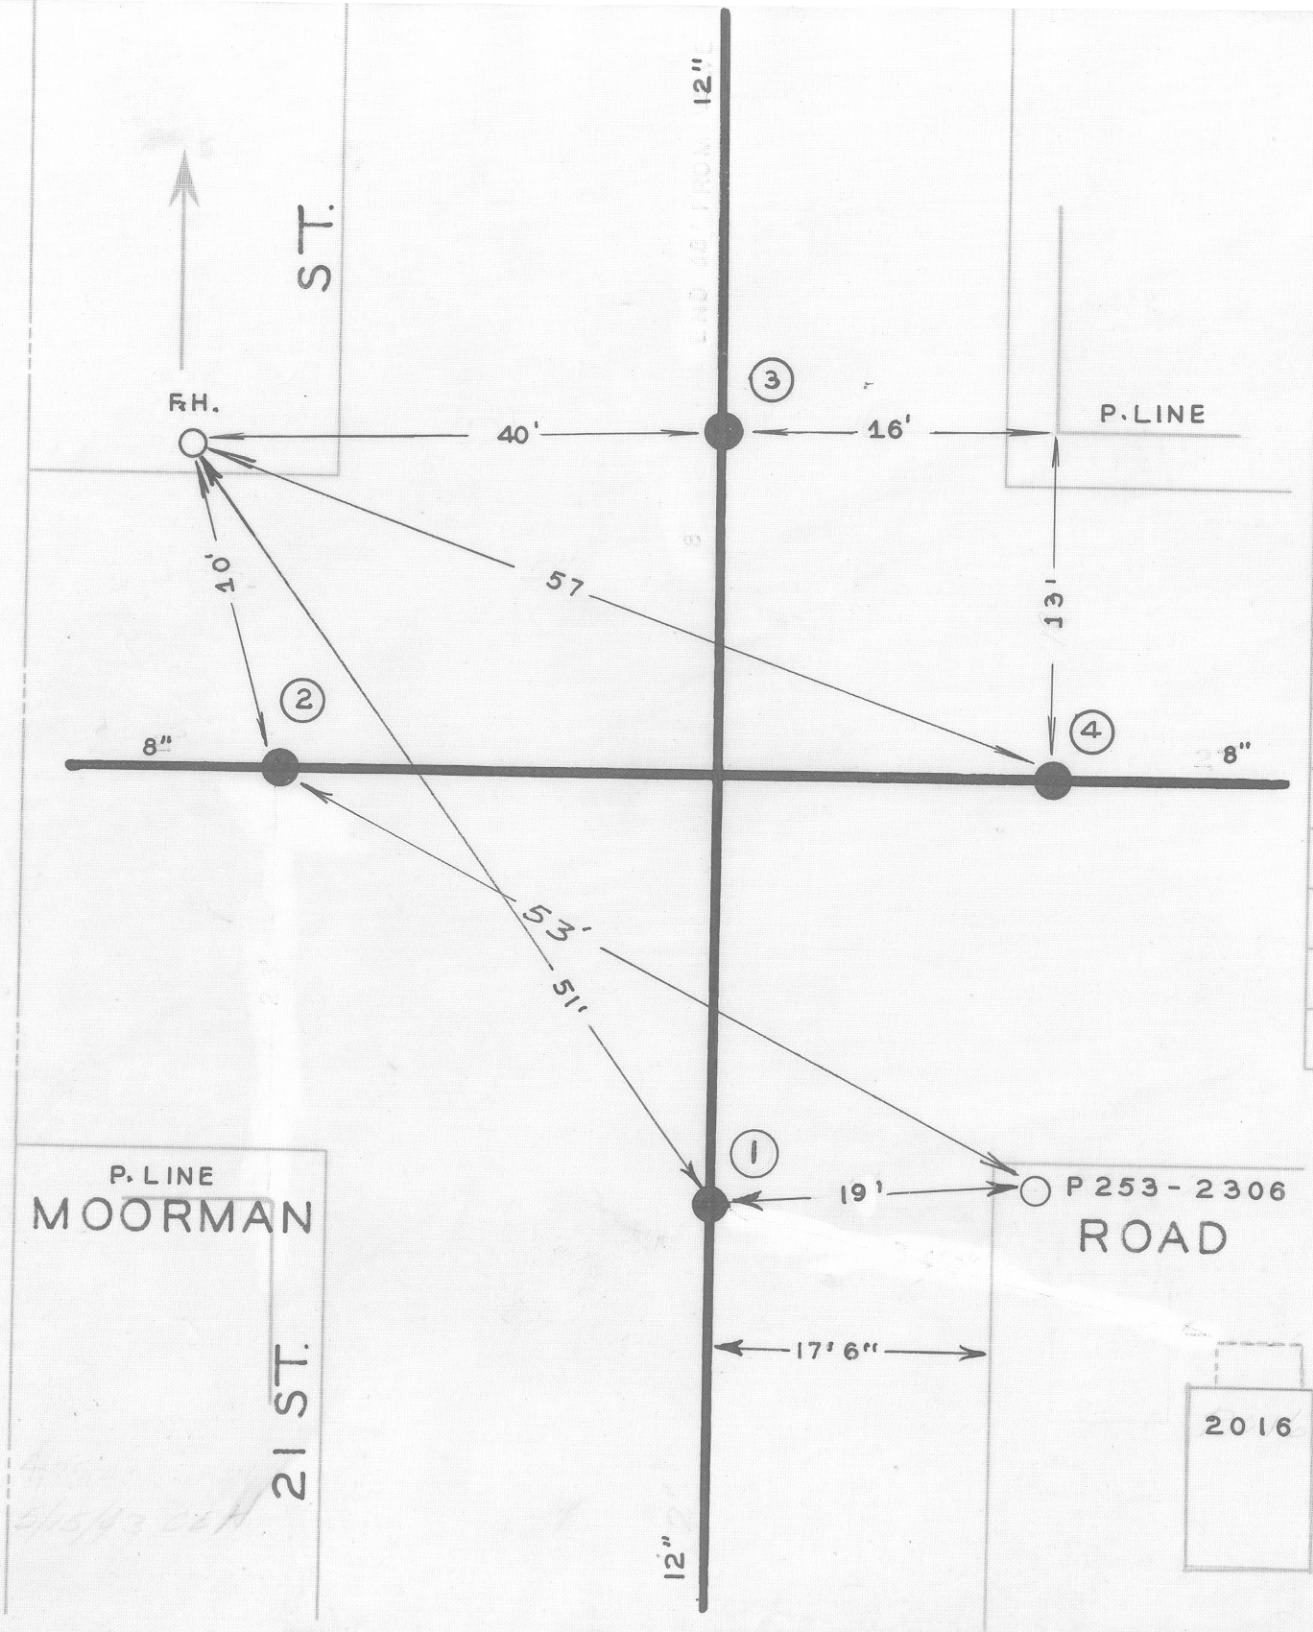

DATE	NO.	SIZE	MAKE	OPEN	TURNS
1-65	1	12"	MUELLER	R	
1951	2	8"	DARLING	R	27
1951	3	12"	DARLING	R	39
1951	4	8"	DARLING	R	27
	1	0	SPL		
	2	0	WPL		
	3	0	NPL		
	4	0	EPL		

2016

CITY OF ROANOKE—WATER DEP'T

VALVE DIAGRAM

MOORMAN ROAD & 21ST ST. N.W.

SEC. MAP 232

DATE

PAGE NO. NW194