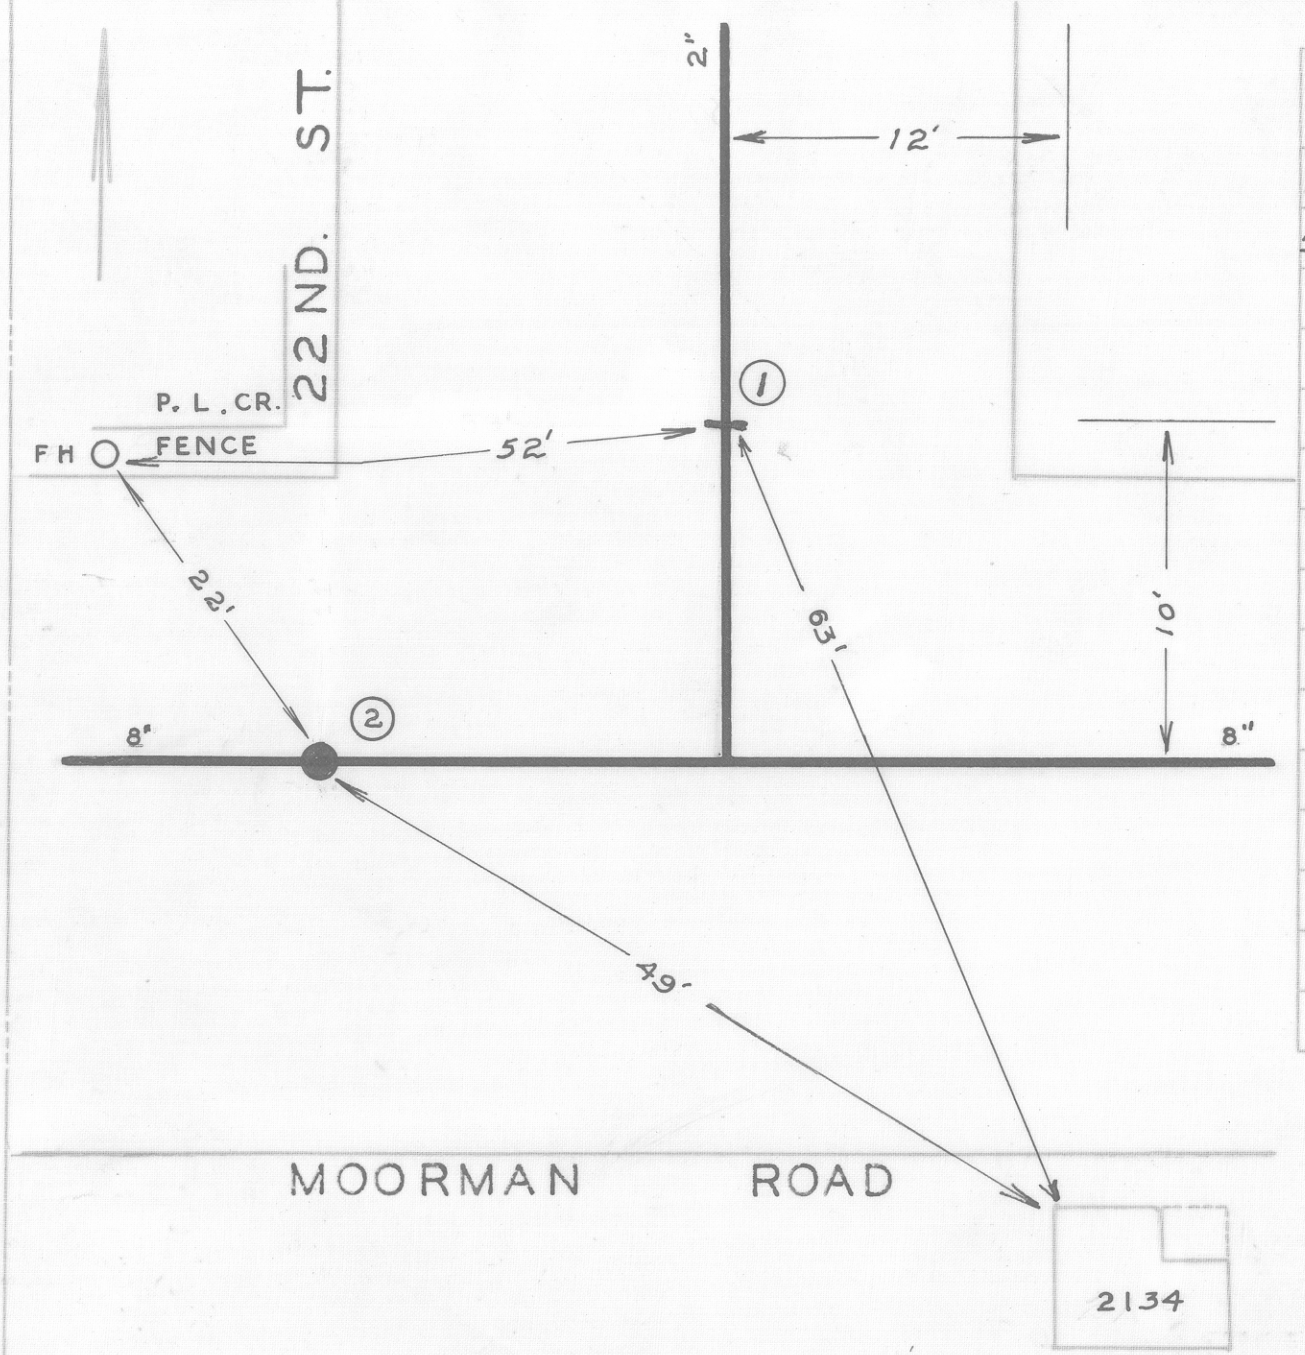

DATE	NO.	SIZE	MAKE	OPEN	TURNS
1916	1	2"		L	6
1951	2	8"	DARLING	R	27
	1	0	NPL		
	2	0	WPL		

CITY OF ROANOKE—WATER DEP'T

VALVE DIAGRAM

MOORMAN ROAD & 22ND ST. N.W.

EAST INTERSECTION

SEC. MAP 232

DATE

PAGE NO. NW 195