DATE	NO.	SIZE	MAKE	OPEN	TURNS
1933	1	11/2"		R	61/2
	1	24" N	SPL		

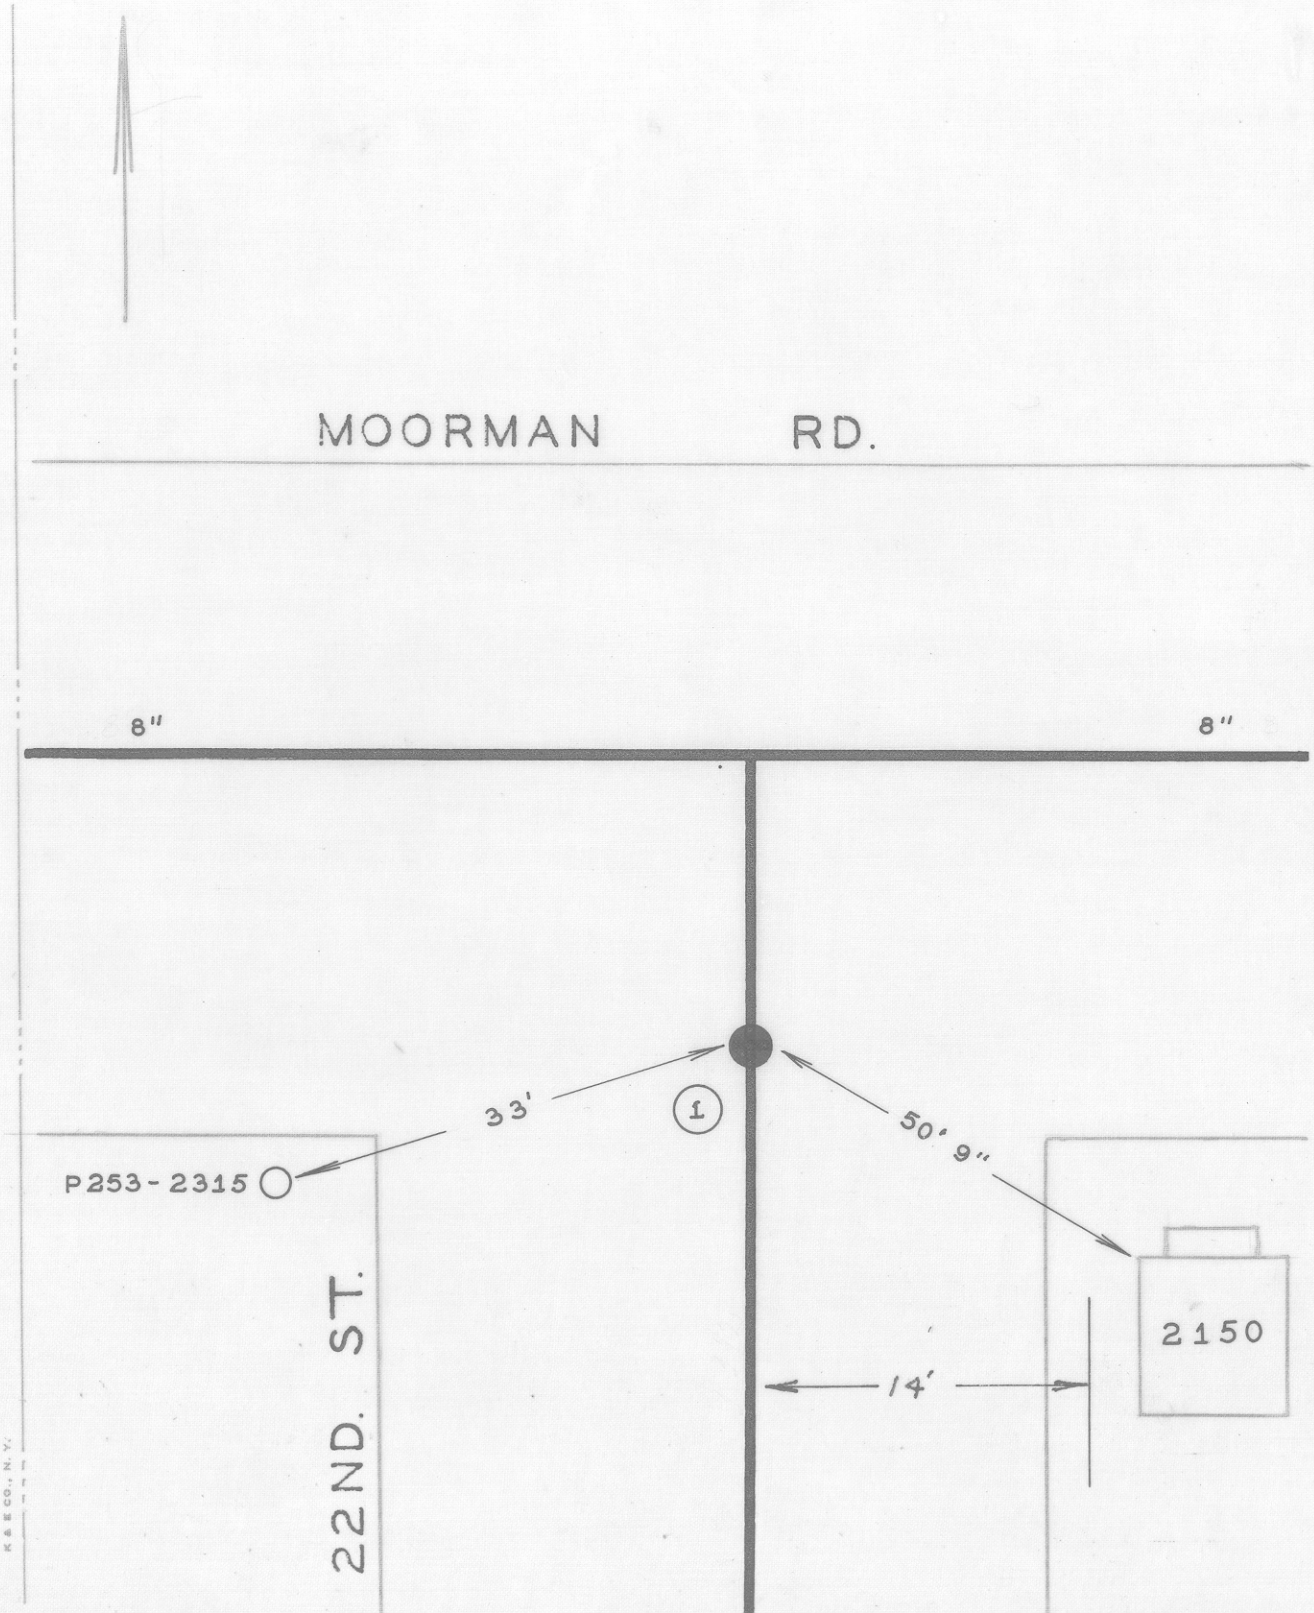

CITY OF ROANOKE — WATER DEPT.

VALVE DIAGRAM

MOORMAN ROAD & 22ND. STREET N.W.

WEST INTERSECTION

SEC. MAP 232

DATE

PAGE NO. N.W.196

"IMPERIAL" TRACING CLOTH K & E CO., N. Y.