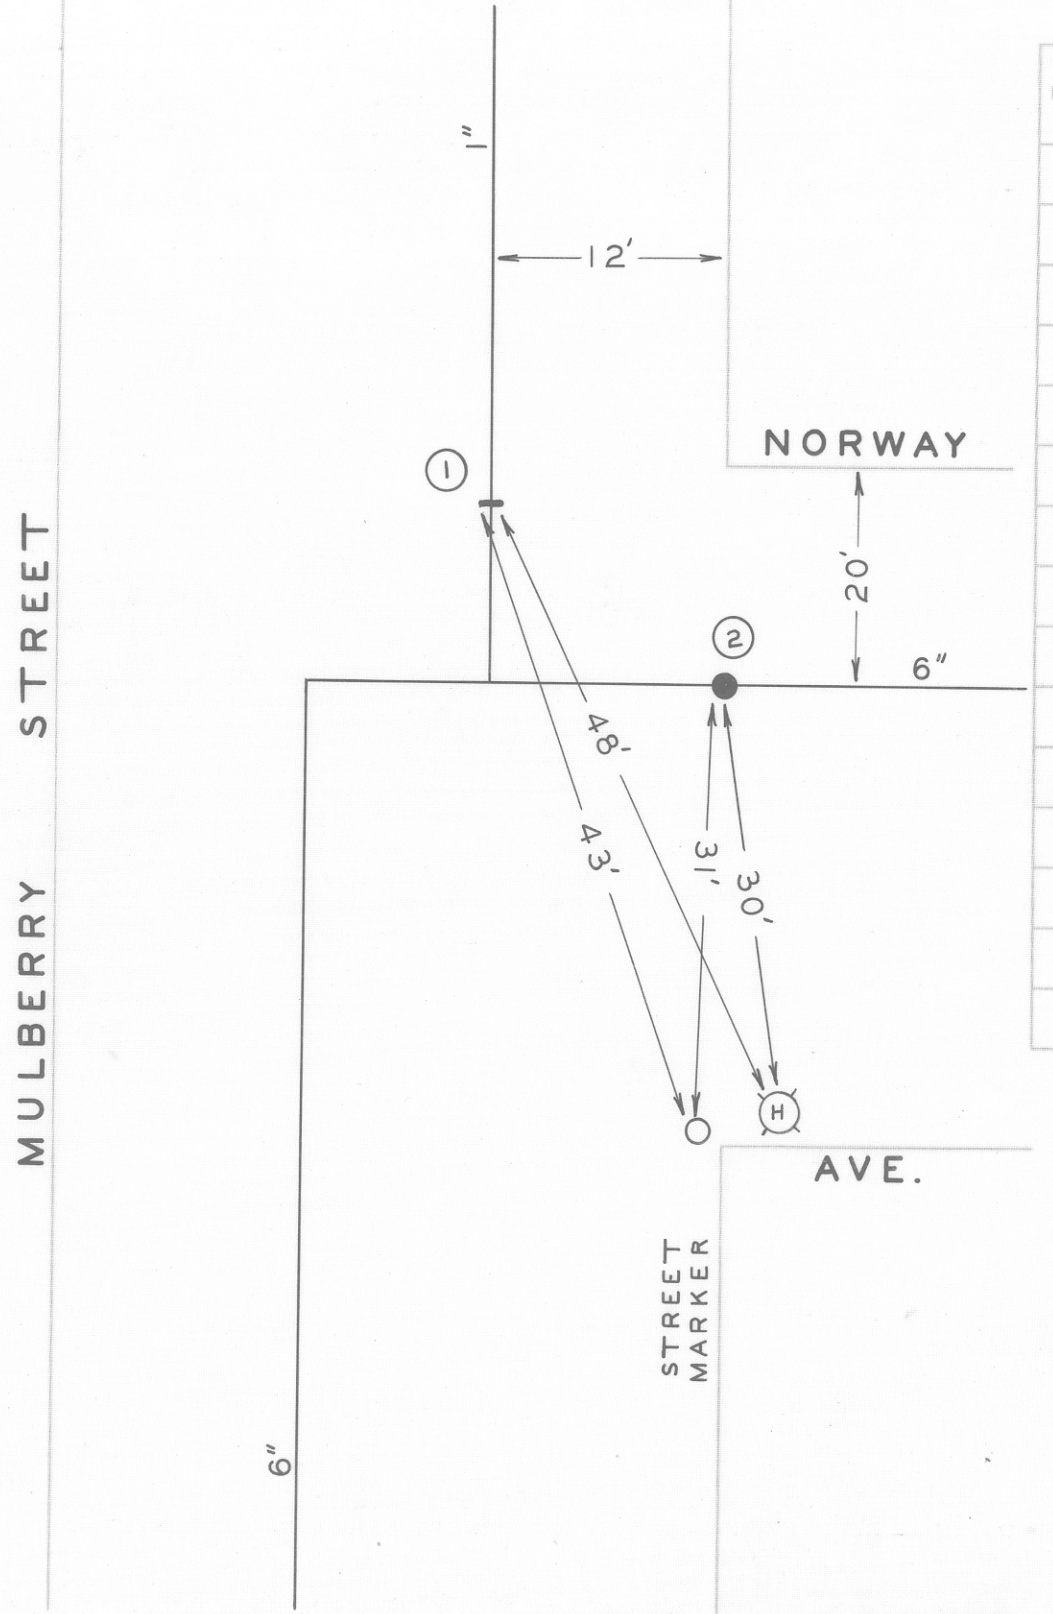


| DATE | NO. | SIZE | MAKE | OPEN | TURNS |
|---|---|---|---|---|---|
| | 1 | 1¼" | | | |
| | 2 | 6" | MUE. | R | 20 |
| | | | | | |
| | | | | | |
| | | | | | |
| | | | | | |
| | | | | | |
| | | | | | |
| | | | | | |
| | | | | | |
| | | | | | |
| | 1 | 6'-S | NPL | | |
| | 2 | 0 | EPL | | |
| | | | | | |
| | | | | | |

CITY OF ROANOKE—WATER DEP'T

VALVE DIAGRAM

MULBERRY ST. &

NORWAY AVE. N.W.

SEC. MAP 263

DATE PAGE NO.