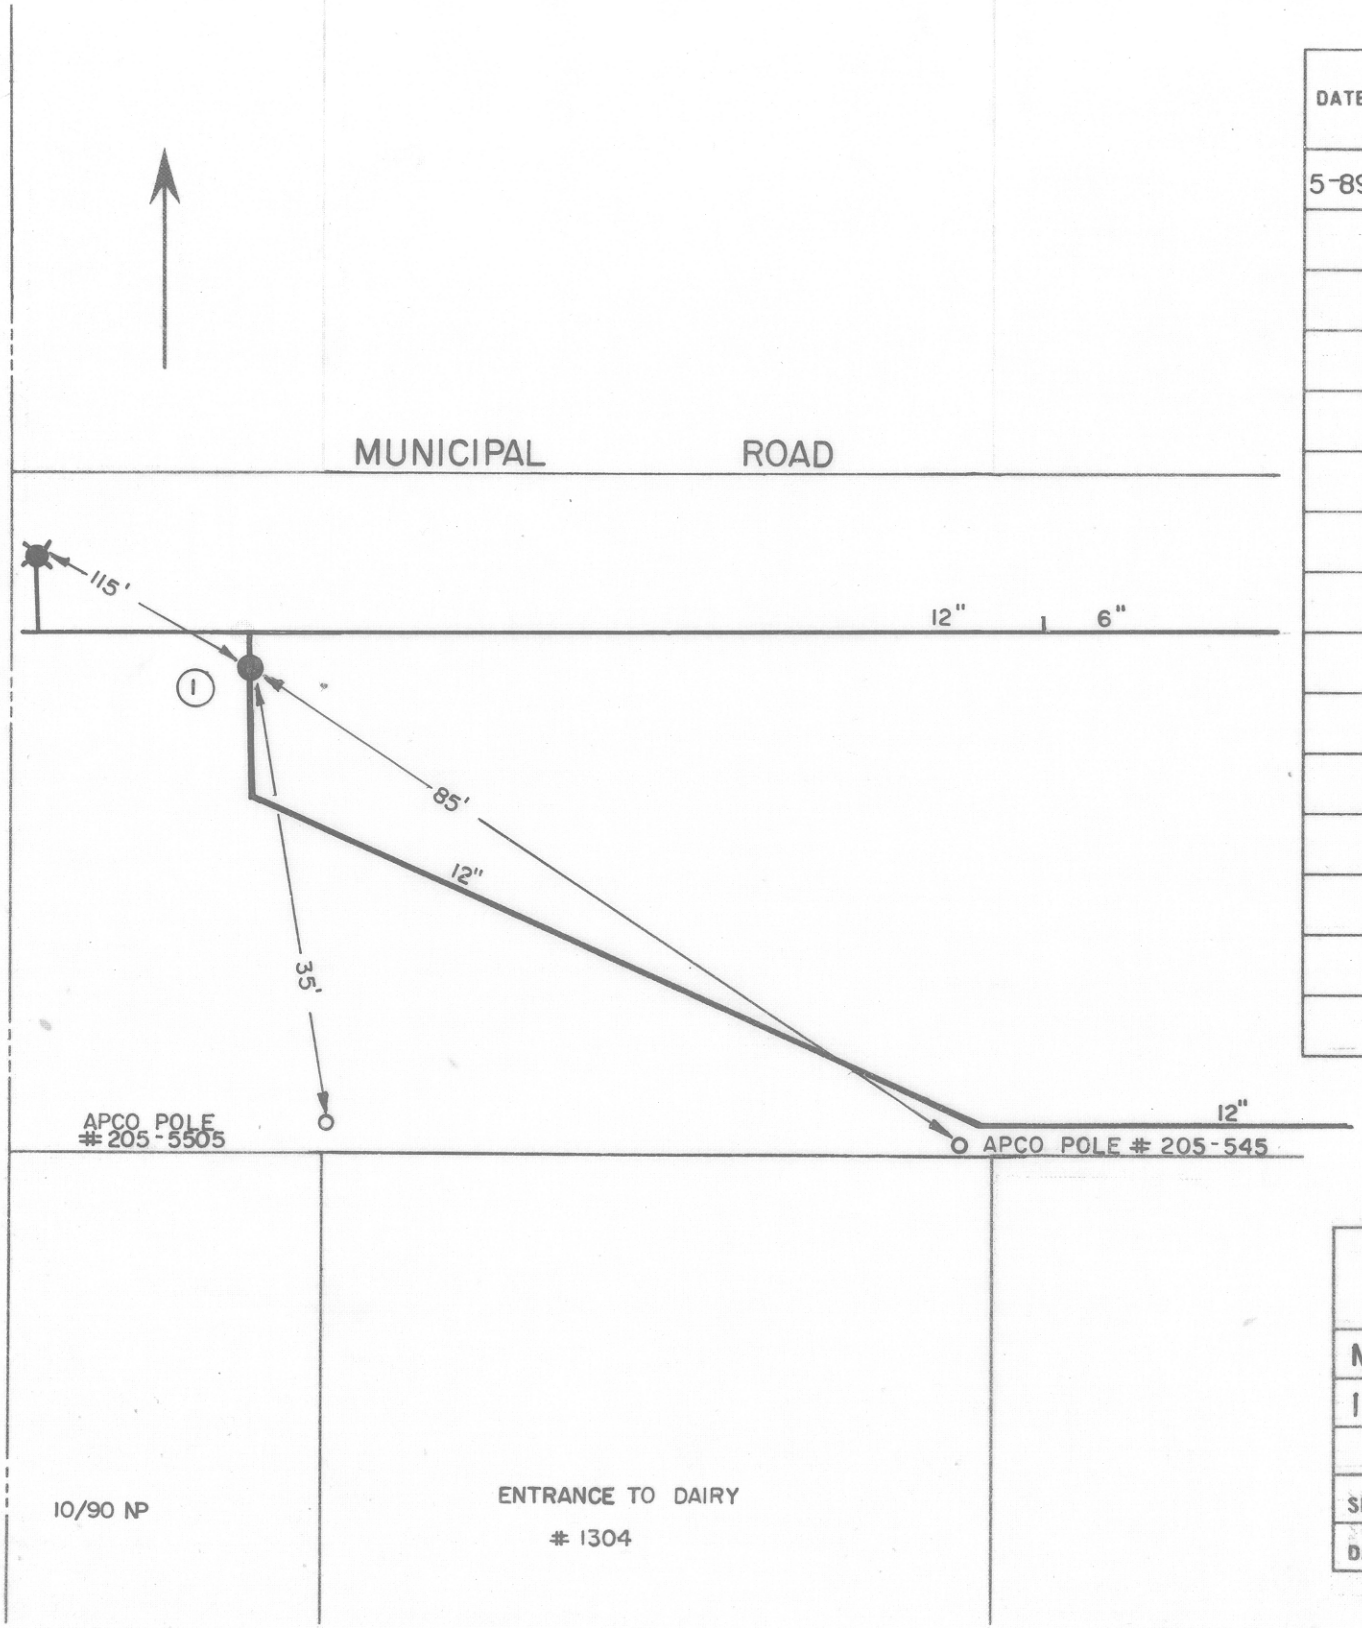

DATE	NO.	SIZE	MAKE	OPEN	TURNS
5-89	1	12"		R	39 1/2

CITY OF ROANOKE—WATER DEP'T

VALVE DIAGRAM

MUNICIPAL ROAD

1300 BLOCK

N.W.

SEC. MAP 664

DATE PAGE NO.