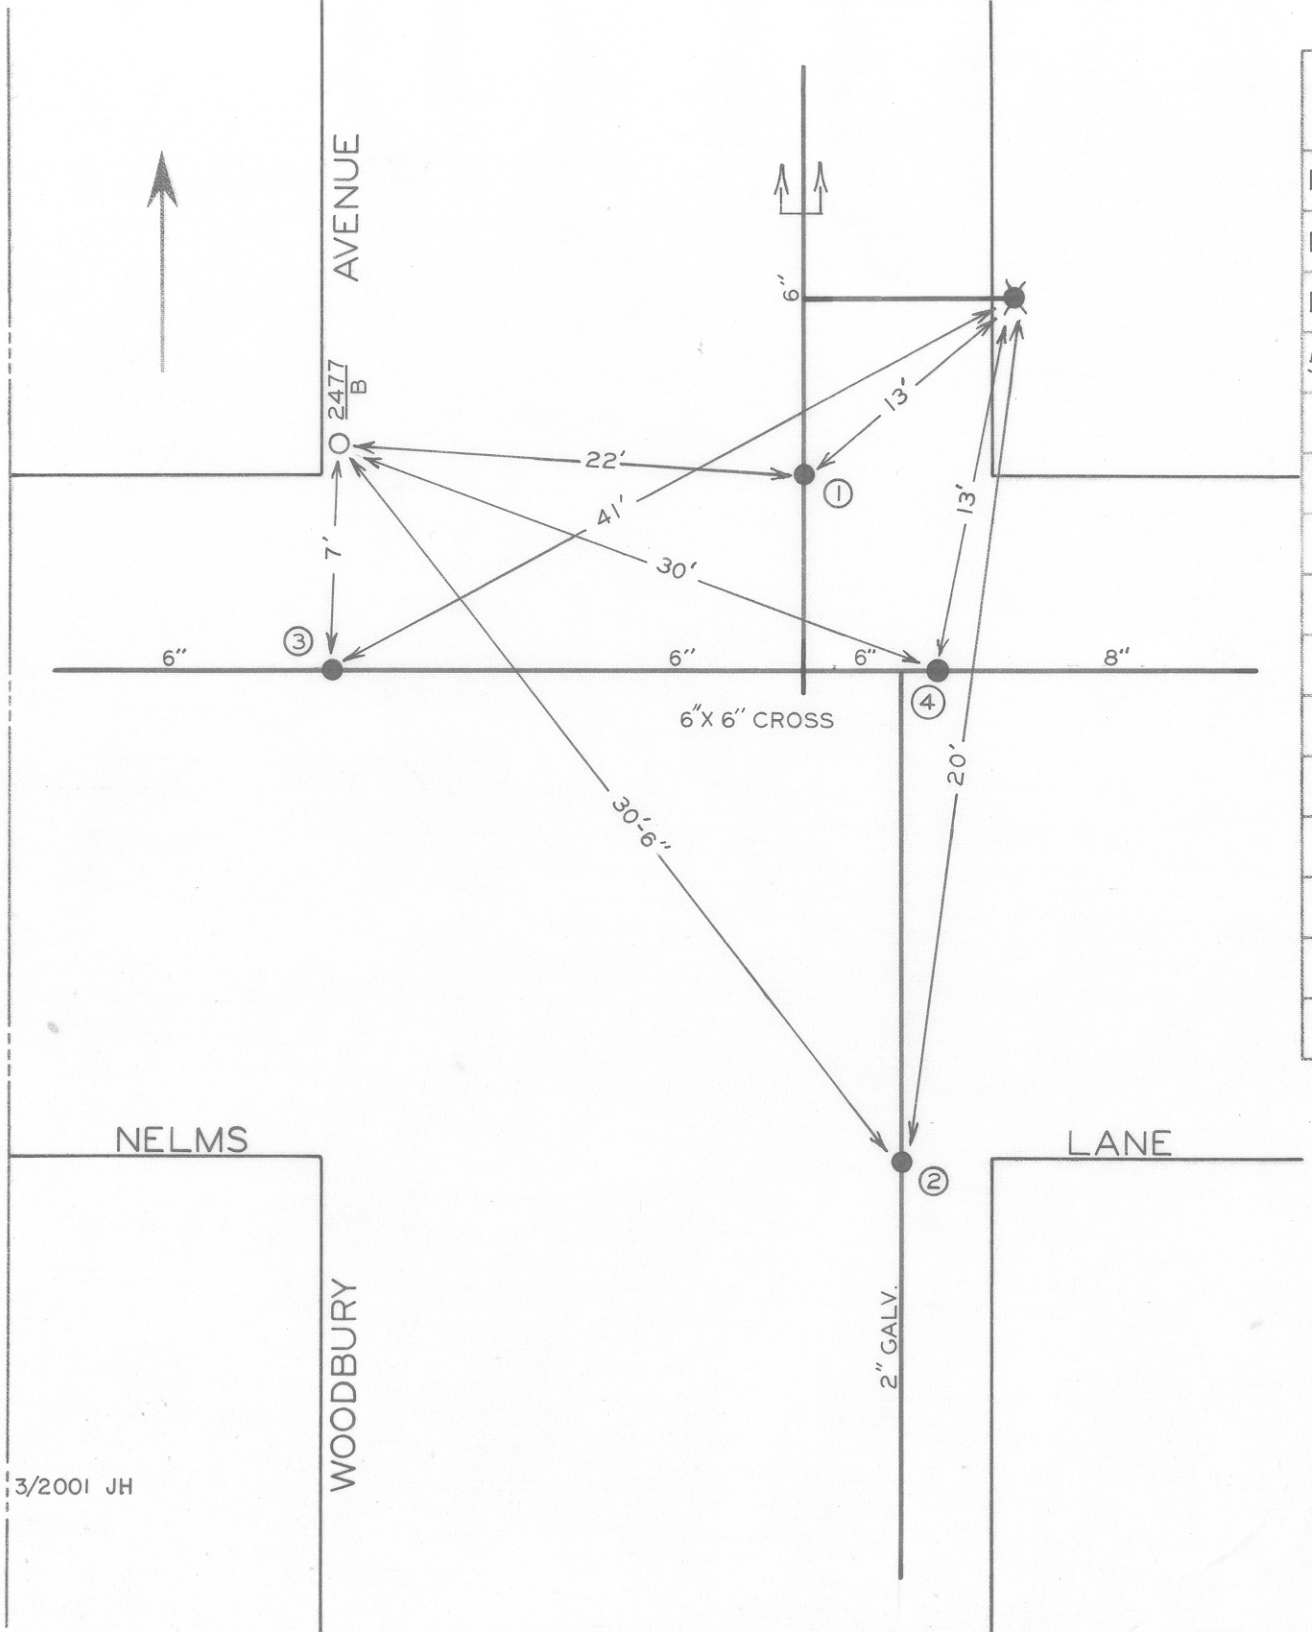

DATE	NO.	SIZE	MAKE	OPEN	TURNS
1955	1	6"	MUELLER	R	21
1951	2	2"	LUNK	L	9
11-69	3	6"	MUELLER	R	21
5-72	4	6"	MUELLER	R	21

3/2001 JH

CITY OF ROANOKE—WATER DEP'T

VALVE DIAGRAM

NELMS LANE &

WOODBURY AVENUE

SEC. MAP 219 N.W.

DATE PAGE NO.