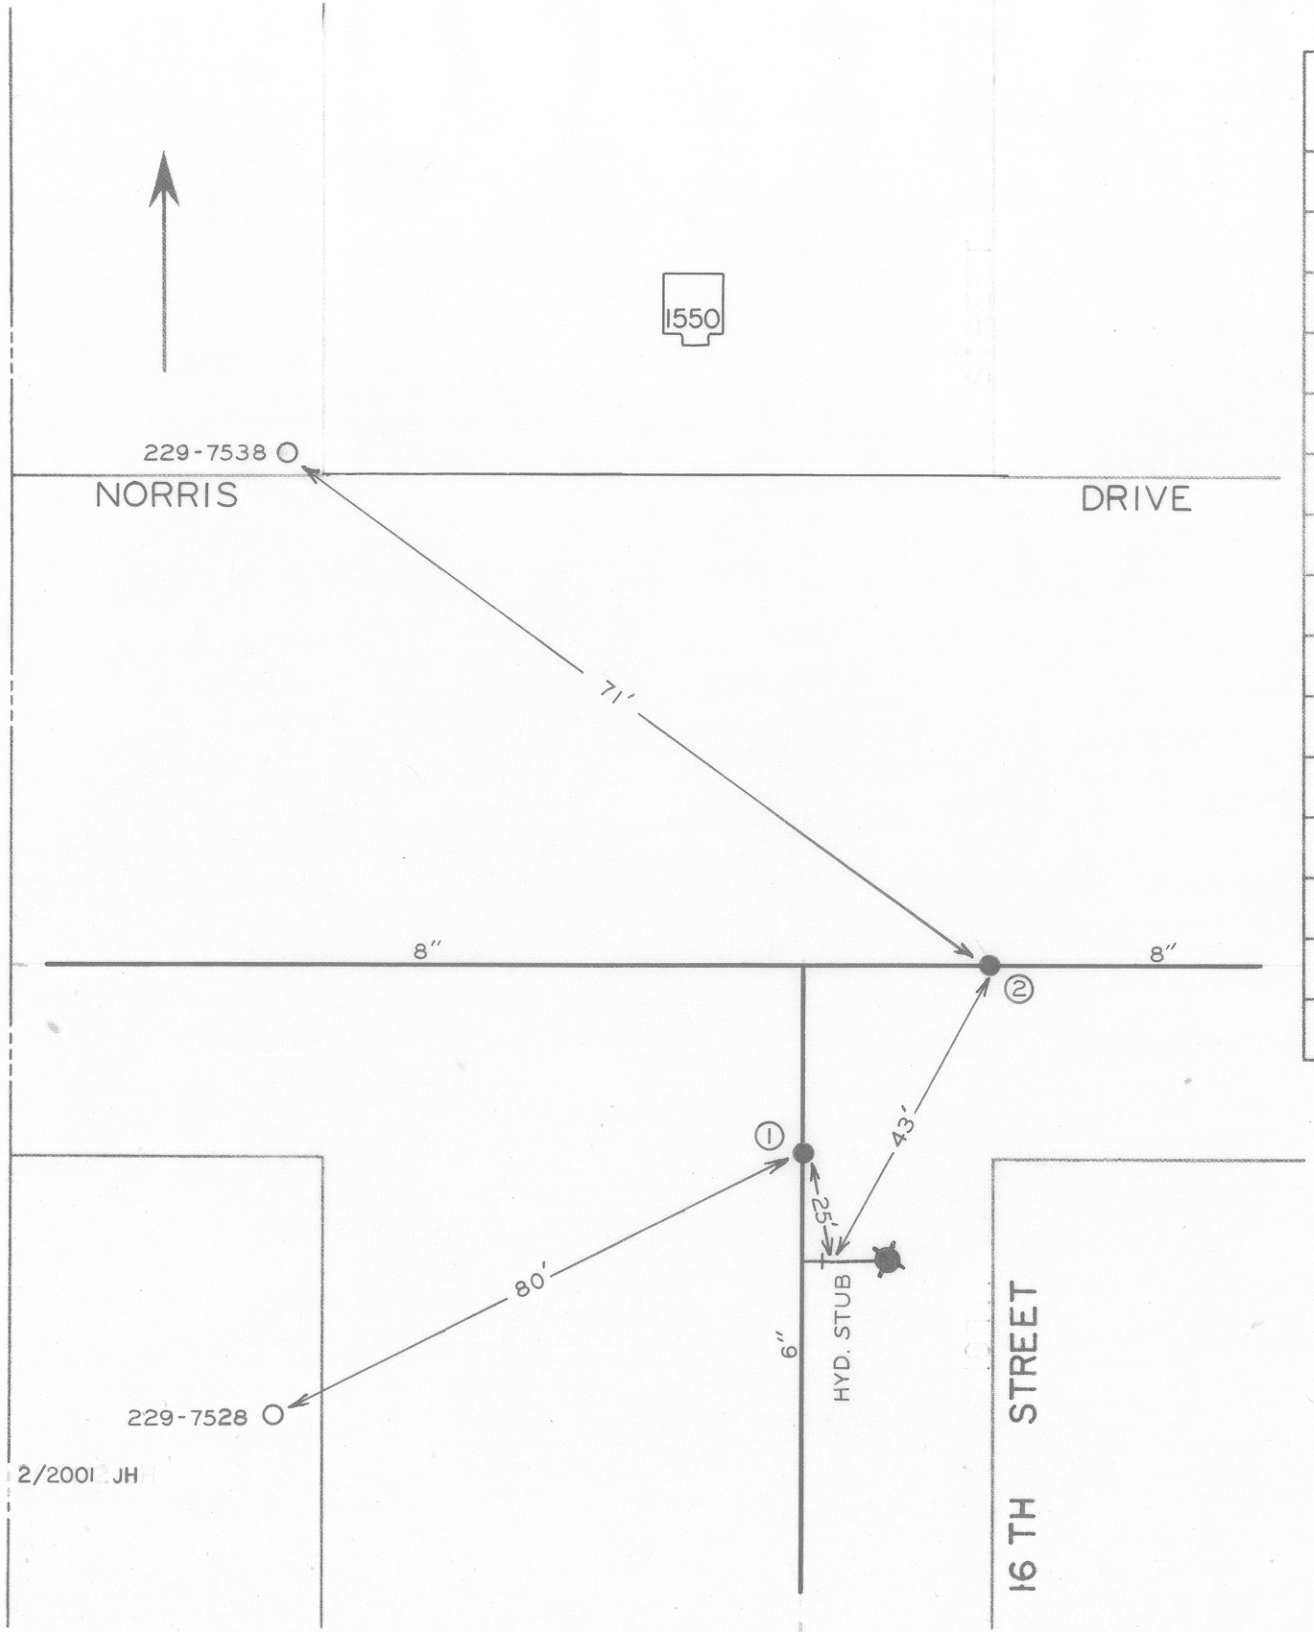

DATE	NO.	SIZE	MAKE	OPEN	TURNS
69	1	6"	MUELLER	R	
69	2	8"	MUELLER	R	

CITY OF ROANOKE—WATER DEP'T

VALVE DIAGRAM

NORRIS DR. & 16TH ST. N.W.

16 TH. STREET

16TH

SEC. MAP 224 N.W.

DATE PAGE NO.