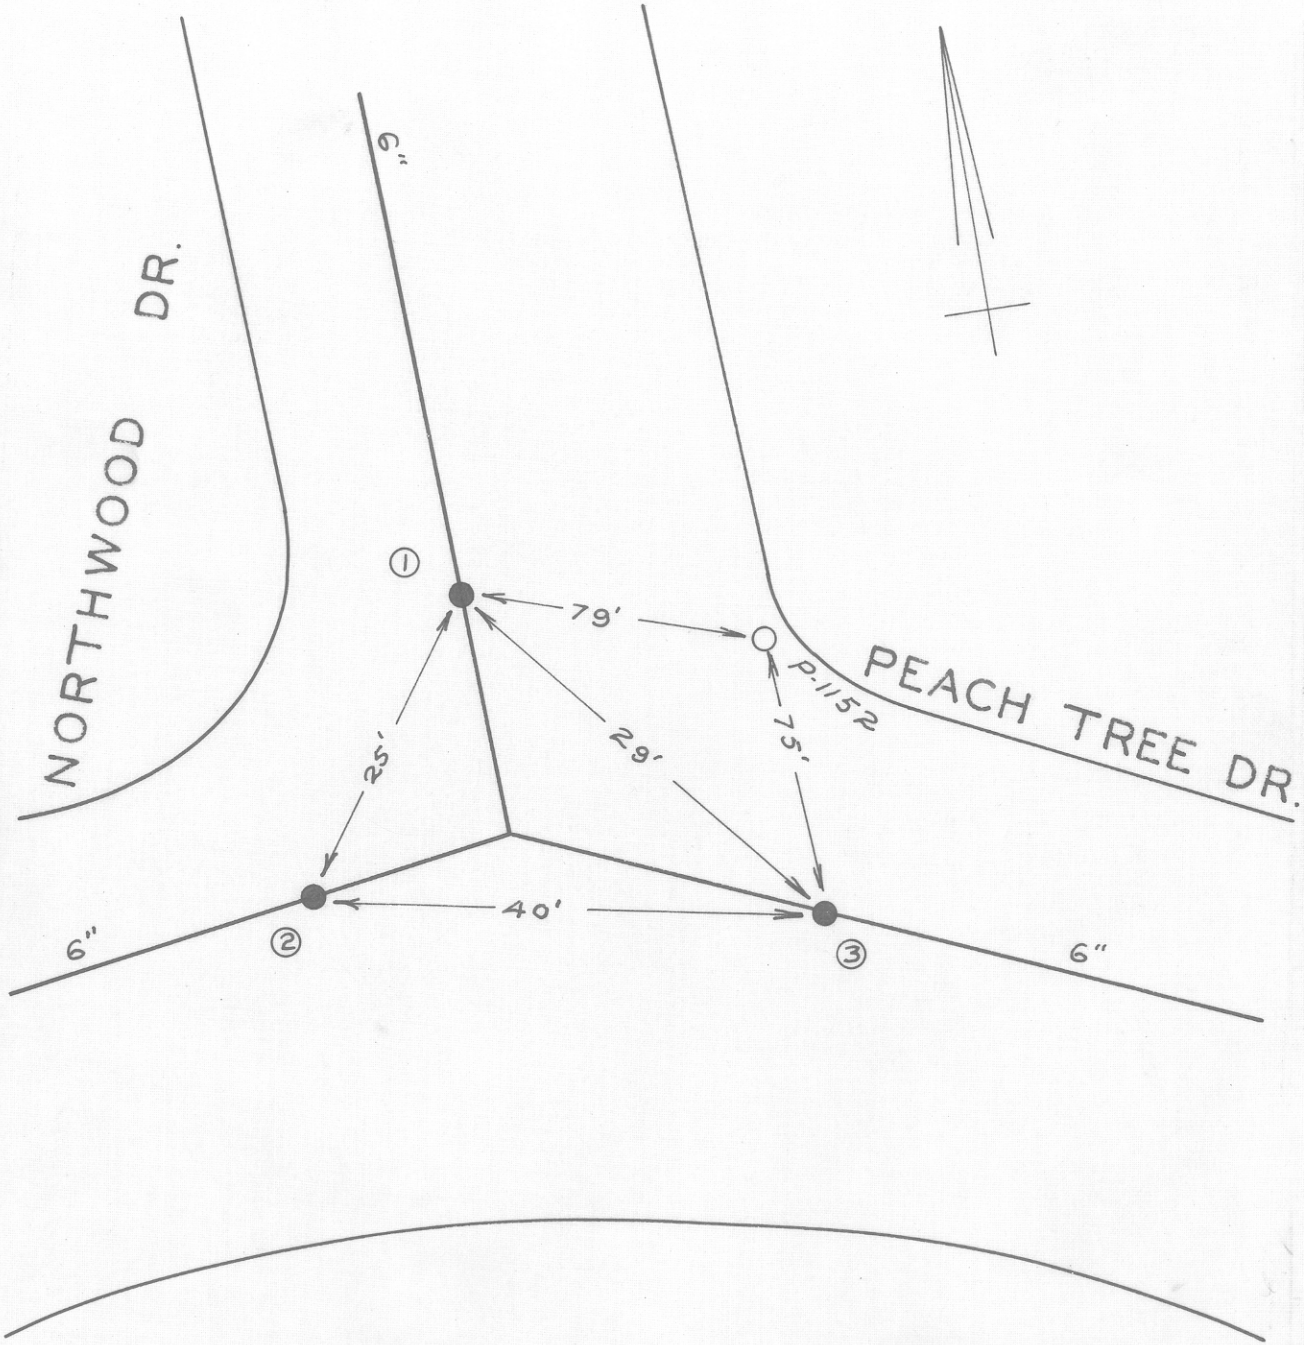

DATE	NO.	SIZE	MAKE	OPEN	TURNS
1954	1	6"			
1954	2	6"			
1954	3	6"			

CITY OF ROANOKE — WATER DEPT.

VALVE DIAGRAM

NORTHWOOD DRIVE &

PEACH TREE DR. N. W.

SEC. MAP 614 N. W.

DATE PAGE NO.

2/2001 JH

"IMPERIAL" TRACING CLOTH. K & E CO., N. Y.