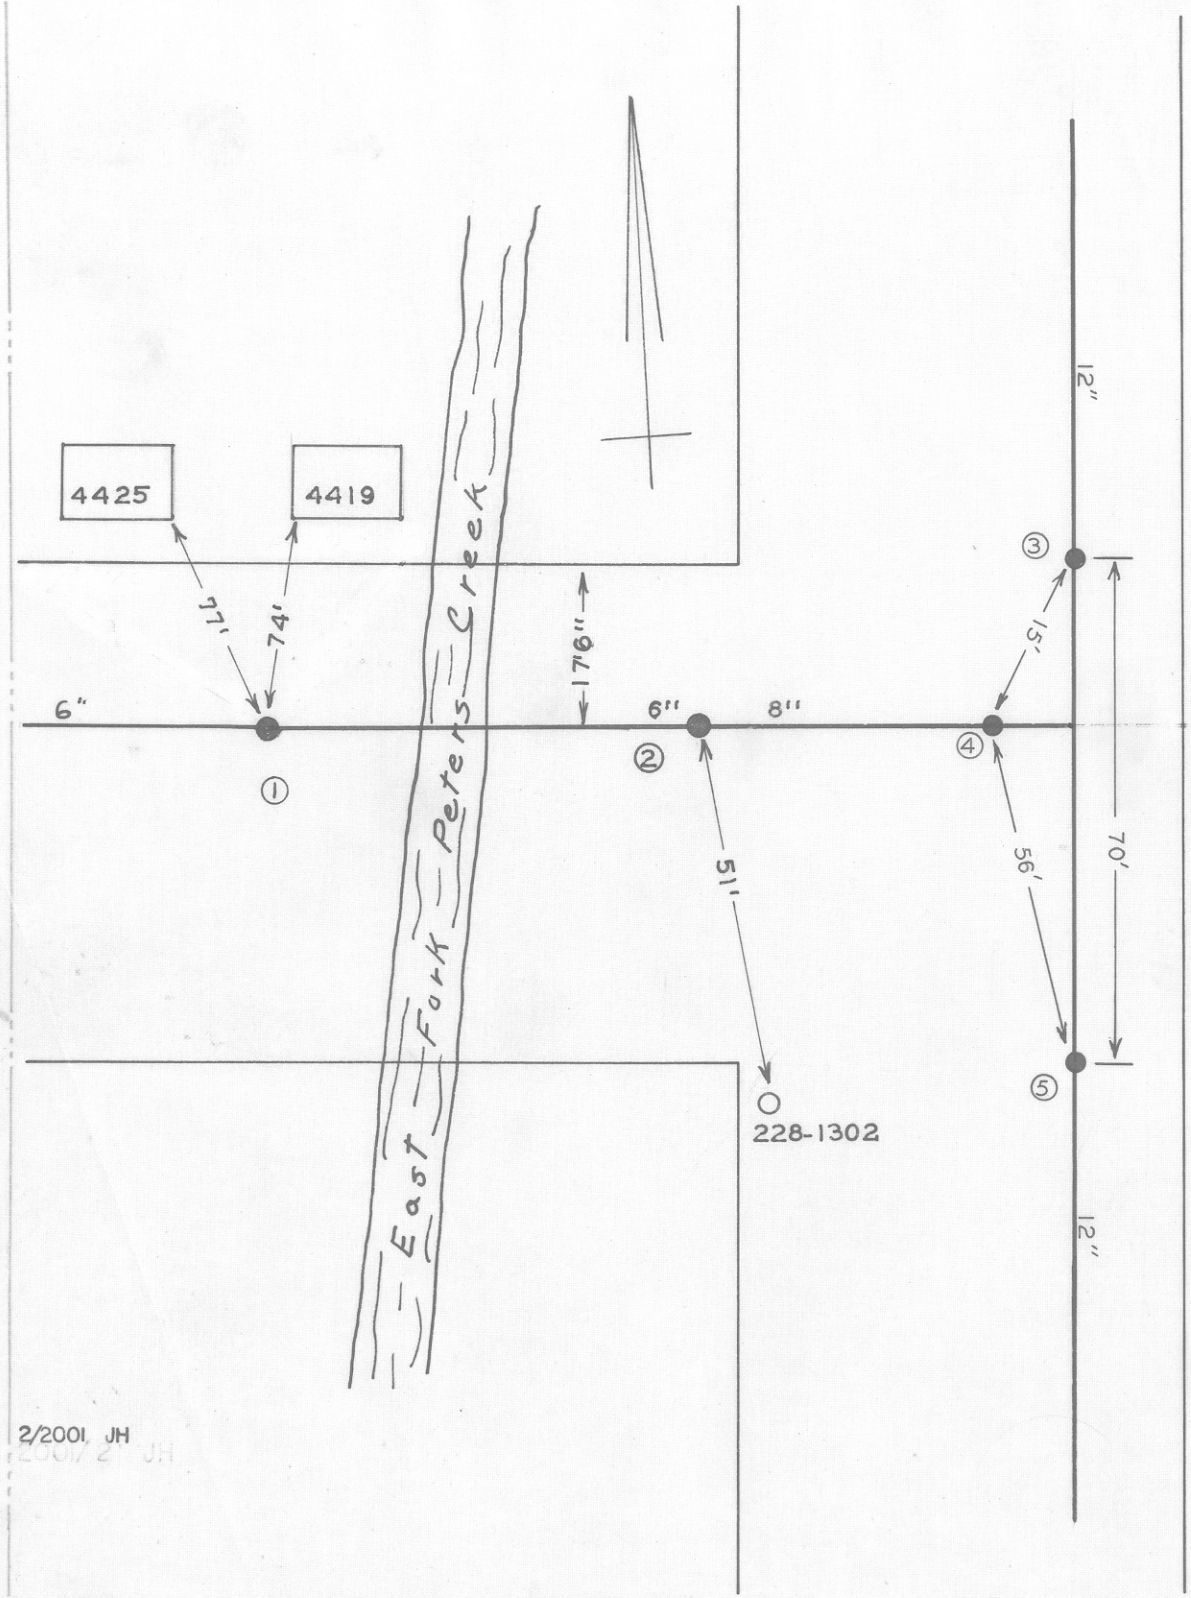


| DATE | NO. | SIZE | MAKE | OPEN | TURNS |
|---|---|---|---|---|---|
| 6-62 | 1 | 6" | DARLING | R | 20 |
| 6-62 | 2 | 6" | DARLING | R | 20 |
| 6-69 | 3 | 12" | MUELLER | R | |
| 6-69 | 4 | 8" | MUELLER | R | |
| 6-69 | 5 | 12" | MUELLER | R | |
| | | | | | |
| | | | | | |
| | | | | | |
| | | | | | |
| | | | | | |
| | 3 | 0' | NPL | | |
| | 4 | 24'W | EPL | | |
| | 5 | 0' | SPL | | |
| | 1 | 218'W | WPL | PETERS C.R. | |
| | 2 | 5'W | W.P.L. | | |

CITY OF ROANOKE—WATER DEPT.

VALVE DIAGRAM

NORTHWOOD DR. &

PETERS CREEK ROAD N.W.

SEC. MAP 614 N. W.

DATE PAGE NO.

2/2001 JH

"IMPERIAL" TRACING CLOTH. K & E CO., N. Y.