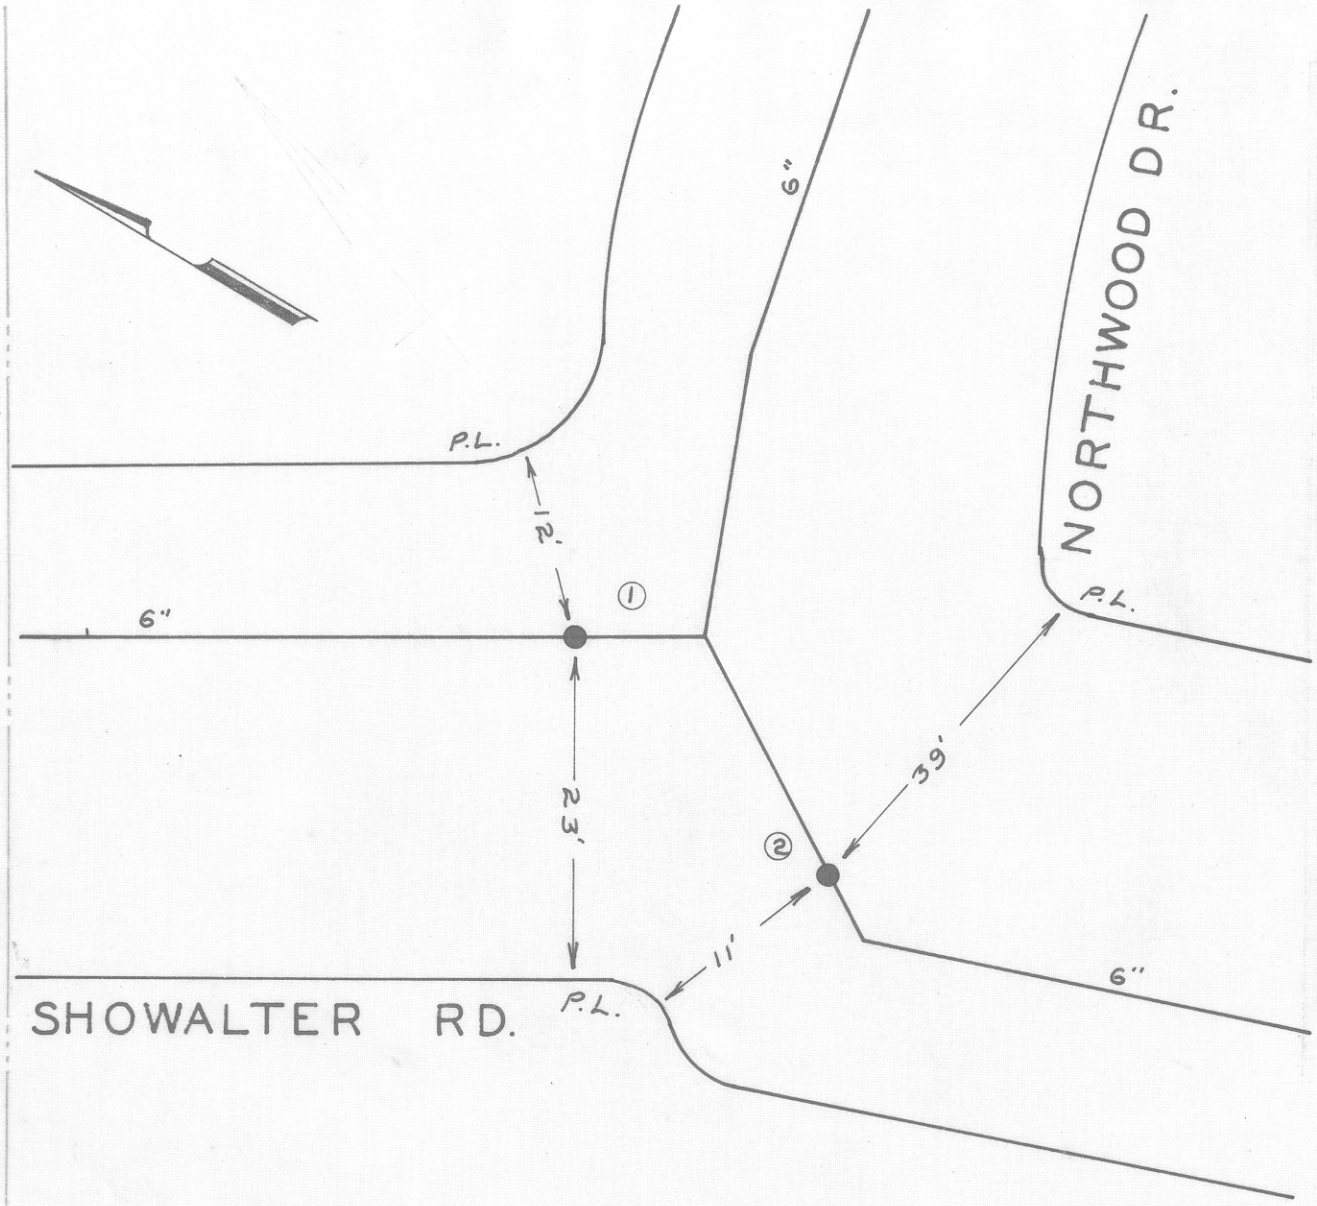

DATE	NO.	SIZE	MAKE	OPEN	TURNS
1955	1	6"	MUELLER		
1955	2	6"	MUELLER		

CITY OF ROANOKE — WATER DEPT.

VALVE DIAGRAM

NORTHWOOD DR. &

SHOWALTER RD.

NORTH INTERSECTION

SEC. MAP 613, 612 N.W.

DATE PAGE NO.

2/2001 JH

"IMPERIAL" TRACING CLOTH. K & E CO., N.Y.