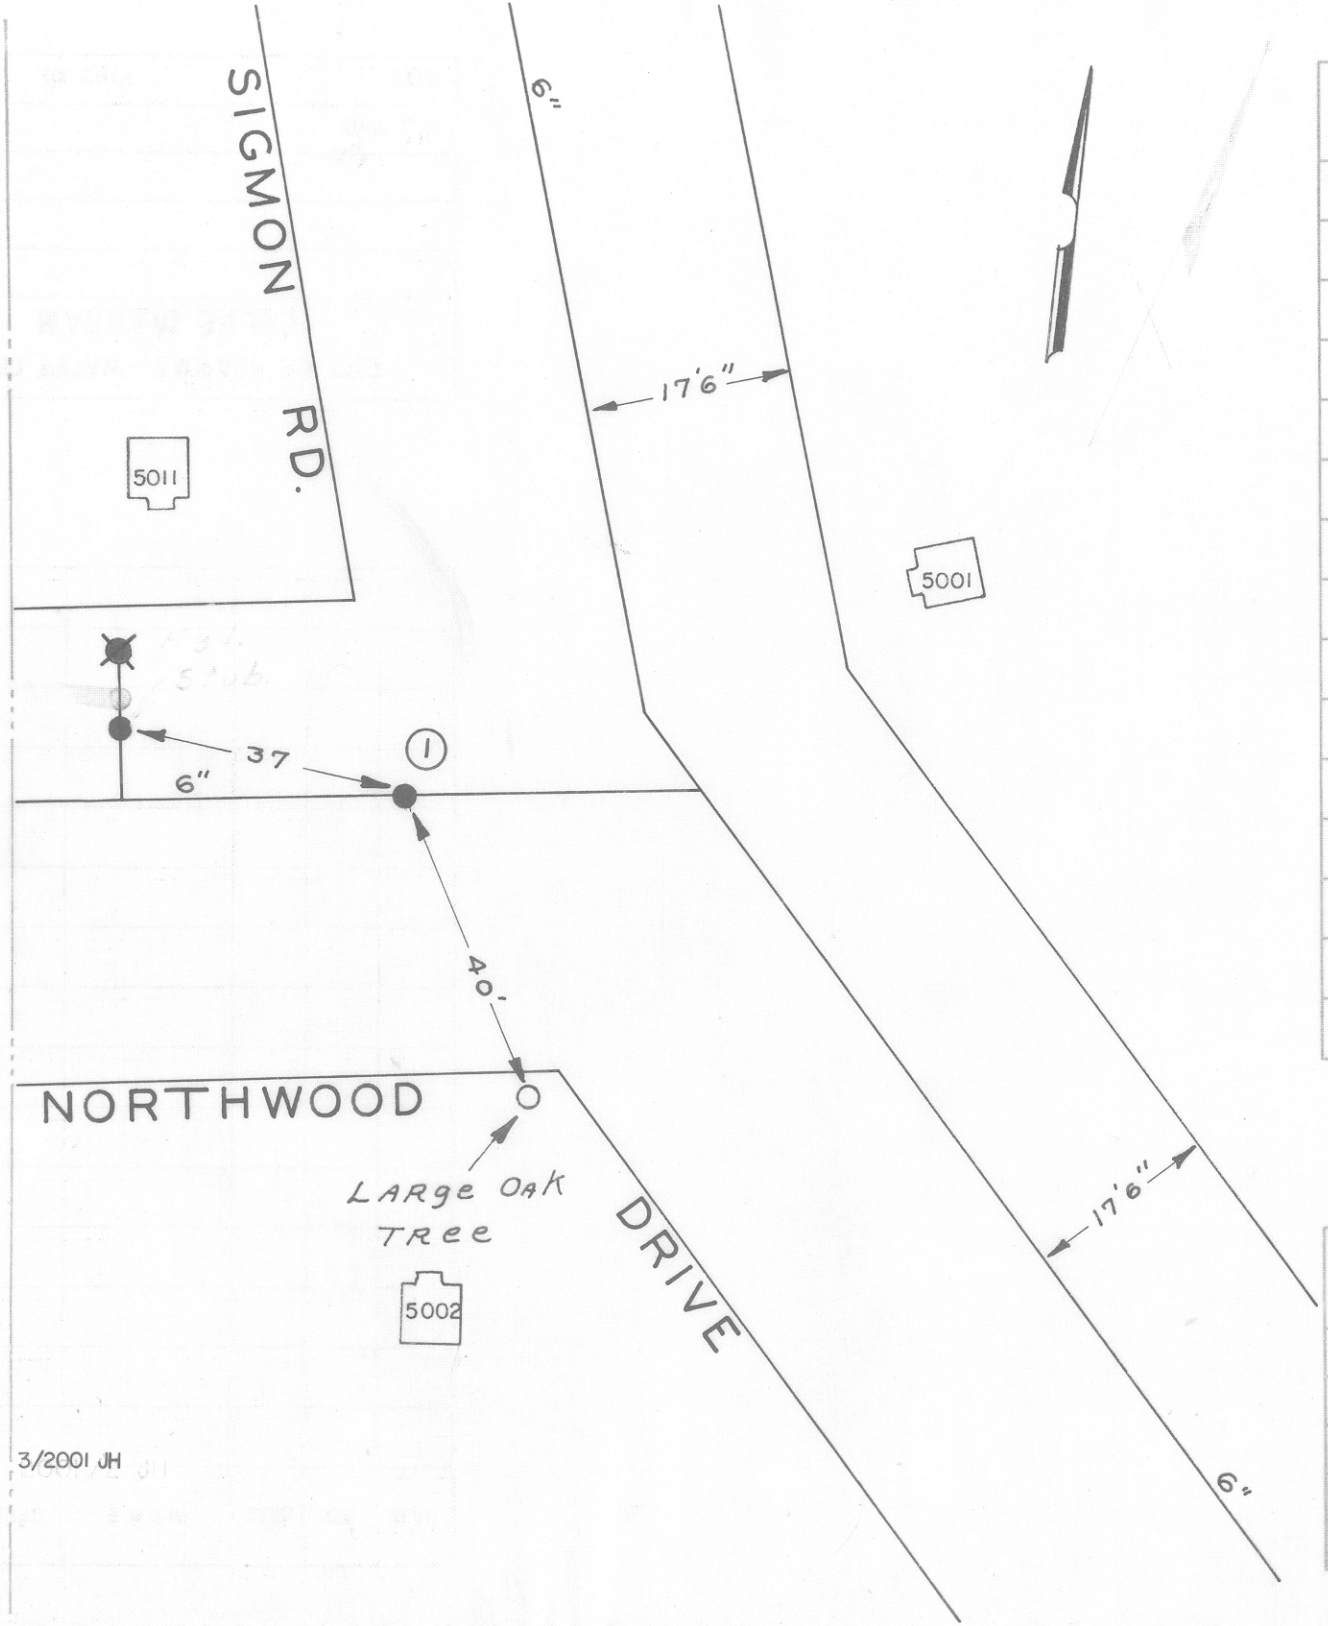

DATE	NO.	SIZE	MAKE	OPEN	TURNS
'58	1	6"	MUELLER	R	20½
	1	0	WPL		

CITY OF ROANOKE—WATER DEPT.

VALVE DIAGRAM

NORTHWOOD DRIVE &

SIGMON ROAD N.W.

SEC. MAP 613 N.W.

DATE PAGE NO.

"IMPERIAL" TRACING CLOTH K & E CO., N. Y.