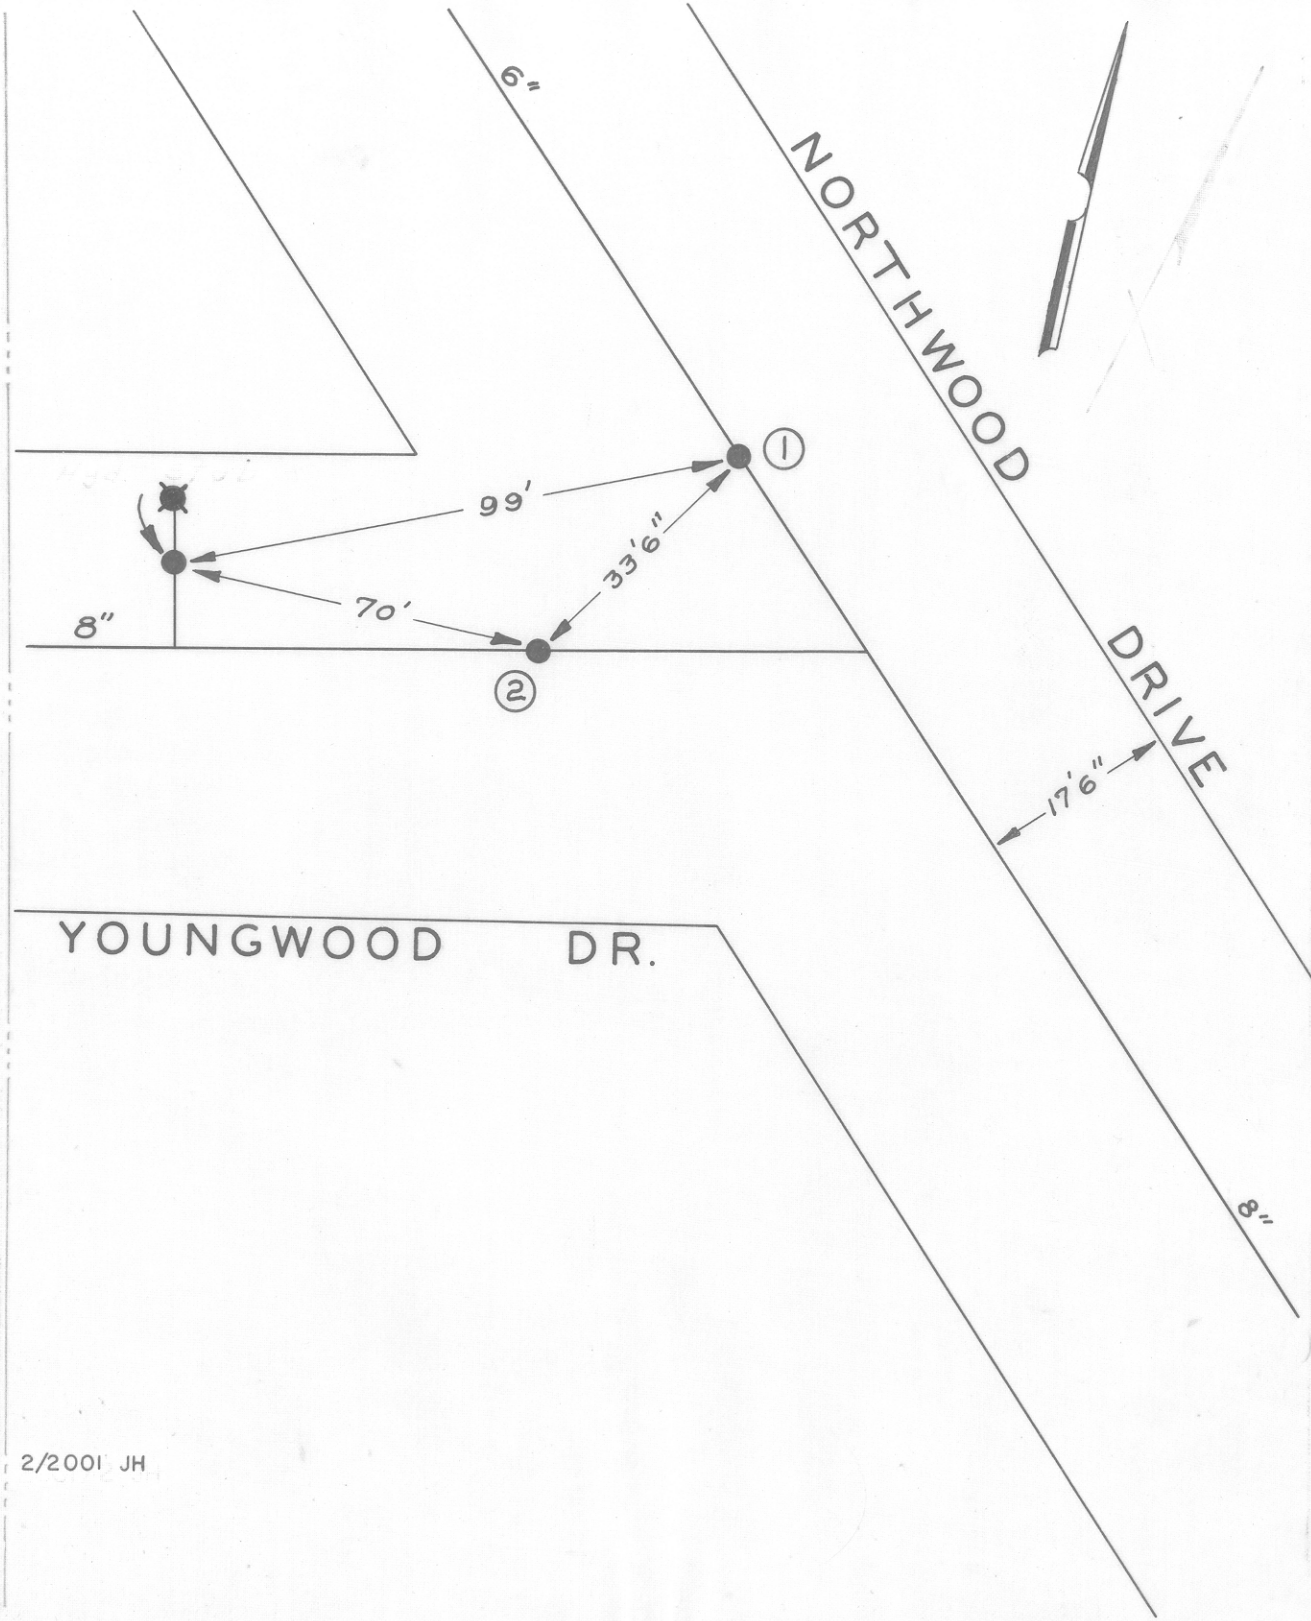

DATE	NO.	SIZE	MAKE	OPEN	TURNS
'58	1	6"	MUELLER	R	20½
'58	2	8"	DARLING	R	27
	1	0	N PL		
	2	0	W PL		

2/2001 JH

CITY OF ROANOKE — WATER DEPT.

VALVE DIAGRAM

NORTHWOOD DRIVE &

YOUNGWOOD DR. N.W.

SEC. MAP 613 N.W.

DATE PAGE NO.

"IMPERIAL" TRACING CLOTH K & E CO., N. Y.