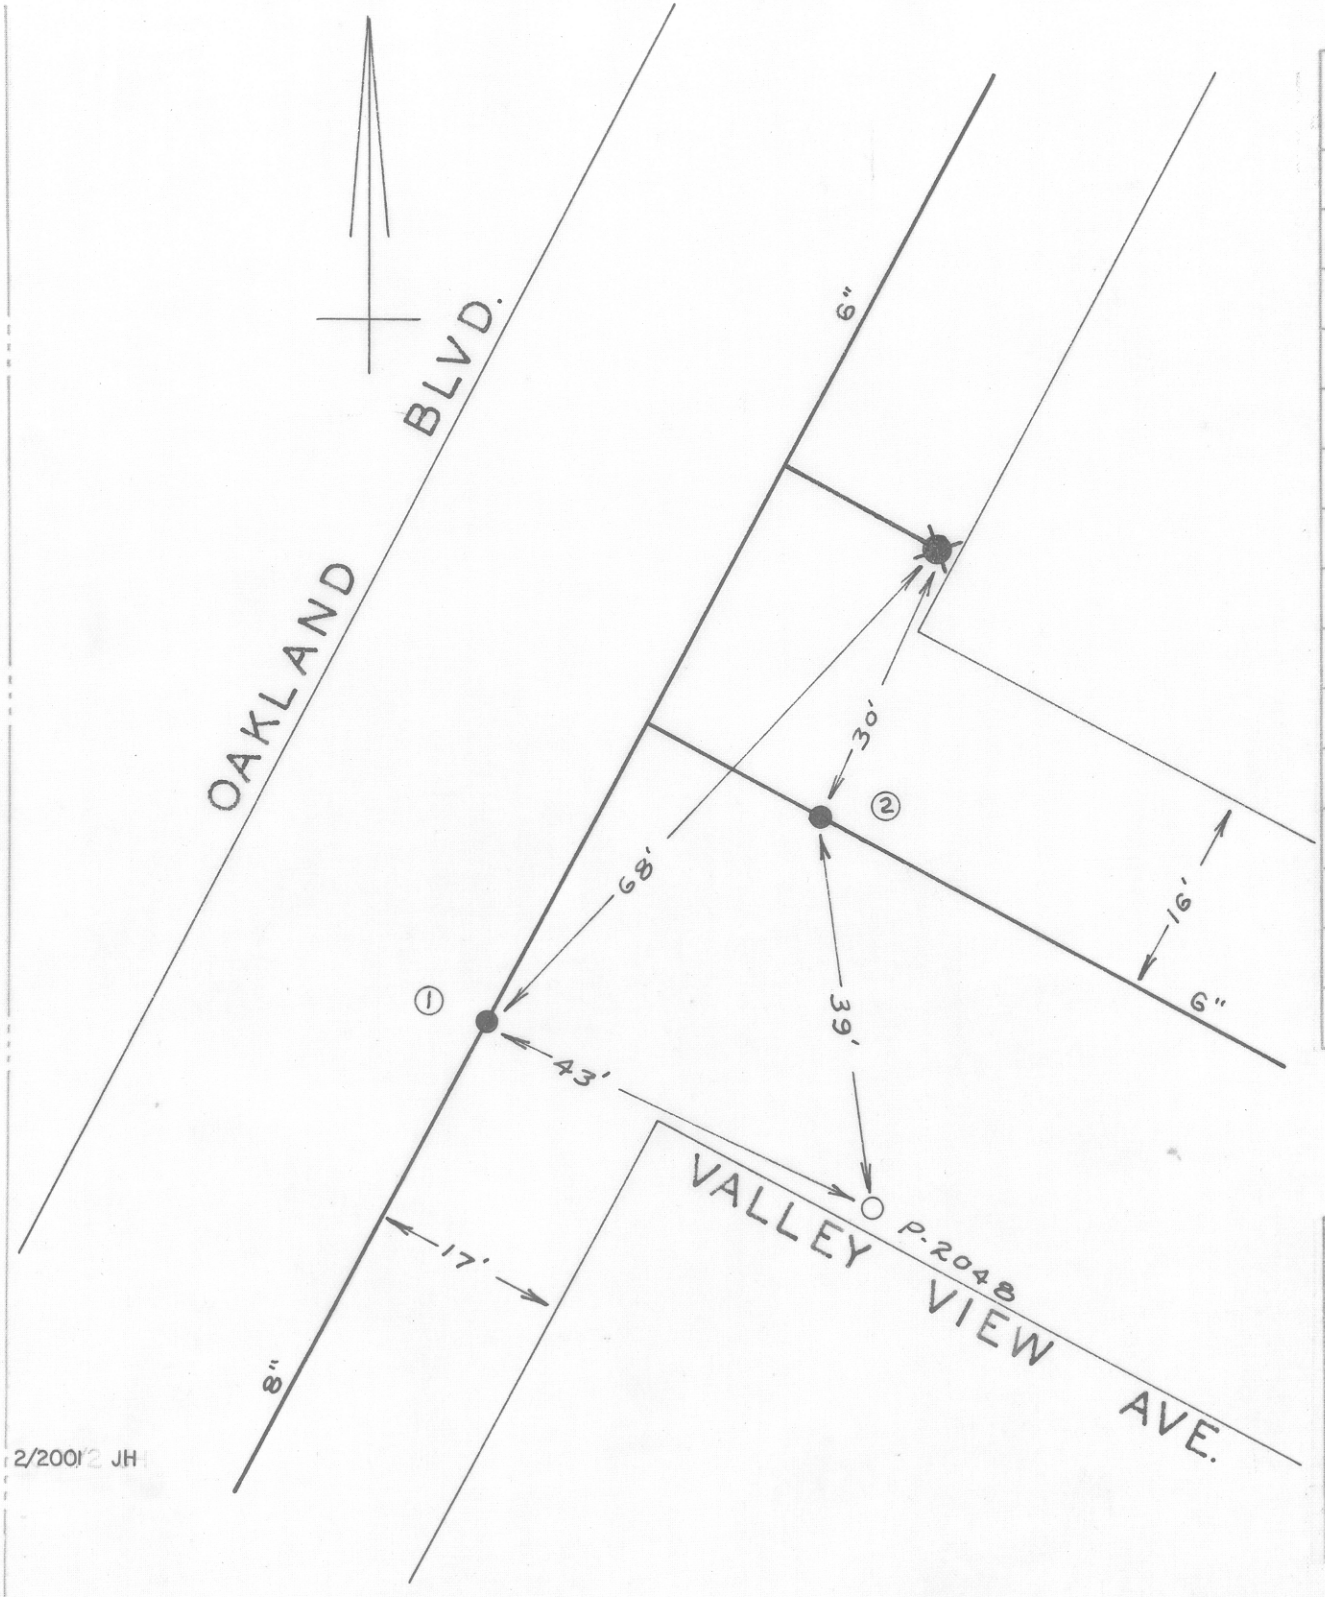

DATE	NO.	SIZE	MAKE	OPEN	TURNS
1953	1	8"	MUELLER	R	27
1951	2	6"	MUELLER	R	20
	1	0	SPL		
	2	0	EPL		

CITY OF ROANOKE—WATER DEPT.

VALVE DIAGRAM

OAKLAND BLVD. &

VALLEY VIEW AVE. N.W.

SEC. MAP 214, 225 N.W.

DATE PAGE NO.

2/2001 JH

"IMPERIAL" TRACING CLOTH
K & E CO., N. Y.