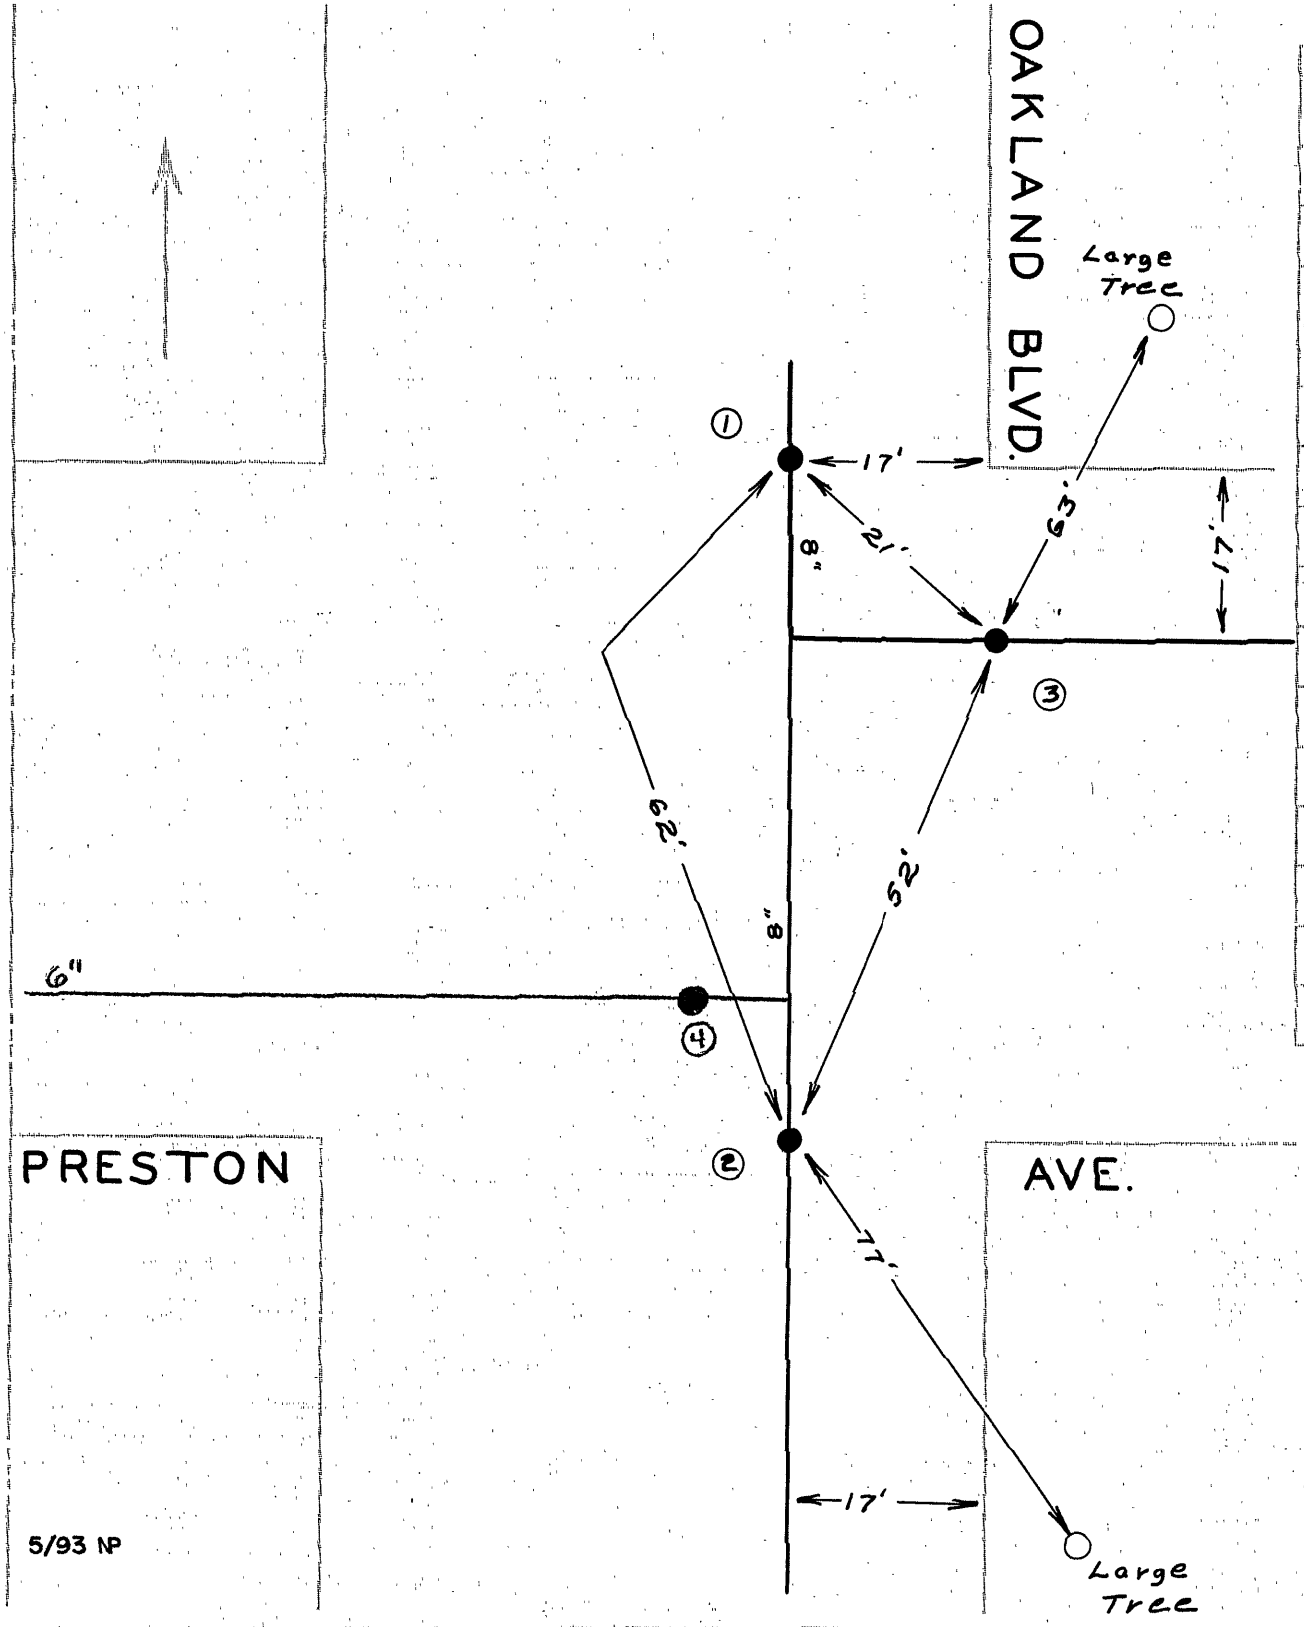

DATE	NO.	SIZE	MAKE	OPEN	TURNS
	1	8"	MUELLER	R	
	2	8"	MUELLER	R	
	3	8"	MUELLER	R	
1986	4	6"			
	1	0	NPL		
	2	0	SPL		
	3	0	EPL		

CITY OF ROANOKE—WATER DEPT

VALVE DIAGRAM

OAKLAND BLVD. &

PRESTON AVE. N.E. OR

N.W.

SEC. MAP 210,319

DATE PAGE NO.

5/93 NP