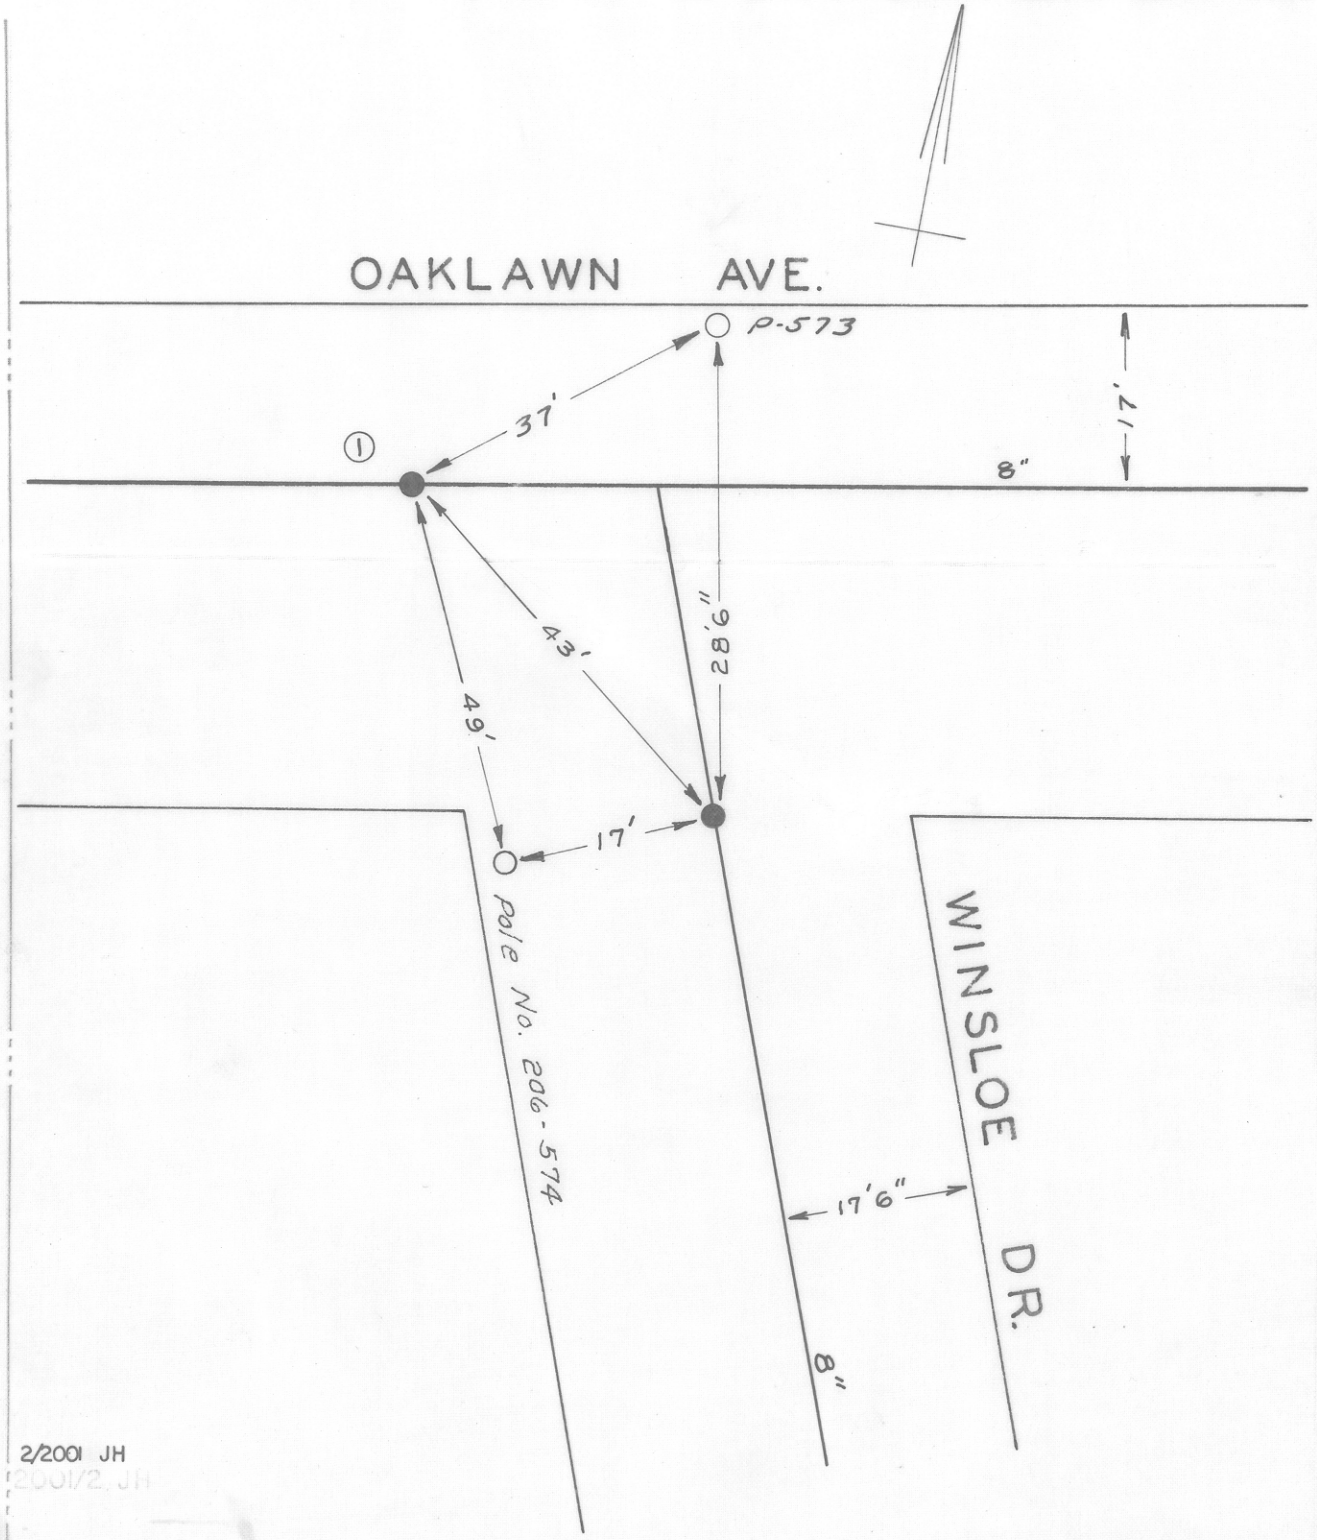

DATE	NO.	SIZE	MAKE	OPEN	TURNS
1953	1	8"			
'59	2	8"	DARLING	R	26
	1	0	WPL		
	2	0	SPL		

CITY OF ROANOKE—WATER DEPT.

VALVE DIAGRAM

OAKLAWN AVE. &

WINSLOE DR. N. W.

WEST INTERSECTION

SEC. MAP 217 N.W.

DATE PAGE NO.

2/2001 JH

2001/2 JH

"IMPERIAL" TRACING CLOTH K & E CO., N. Y.