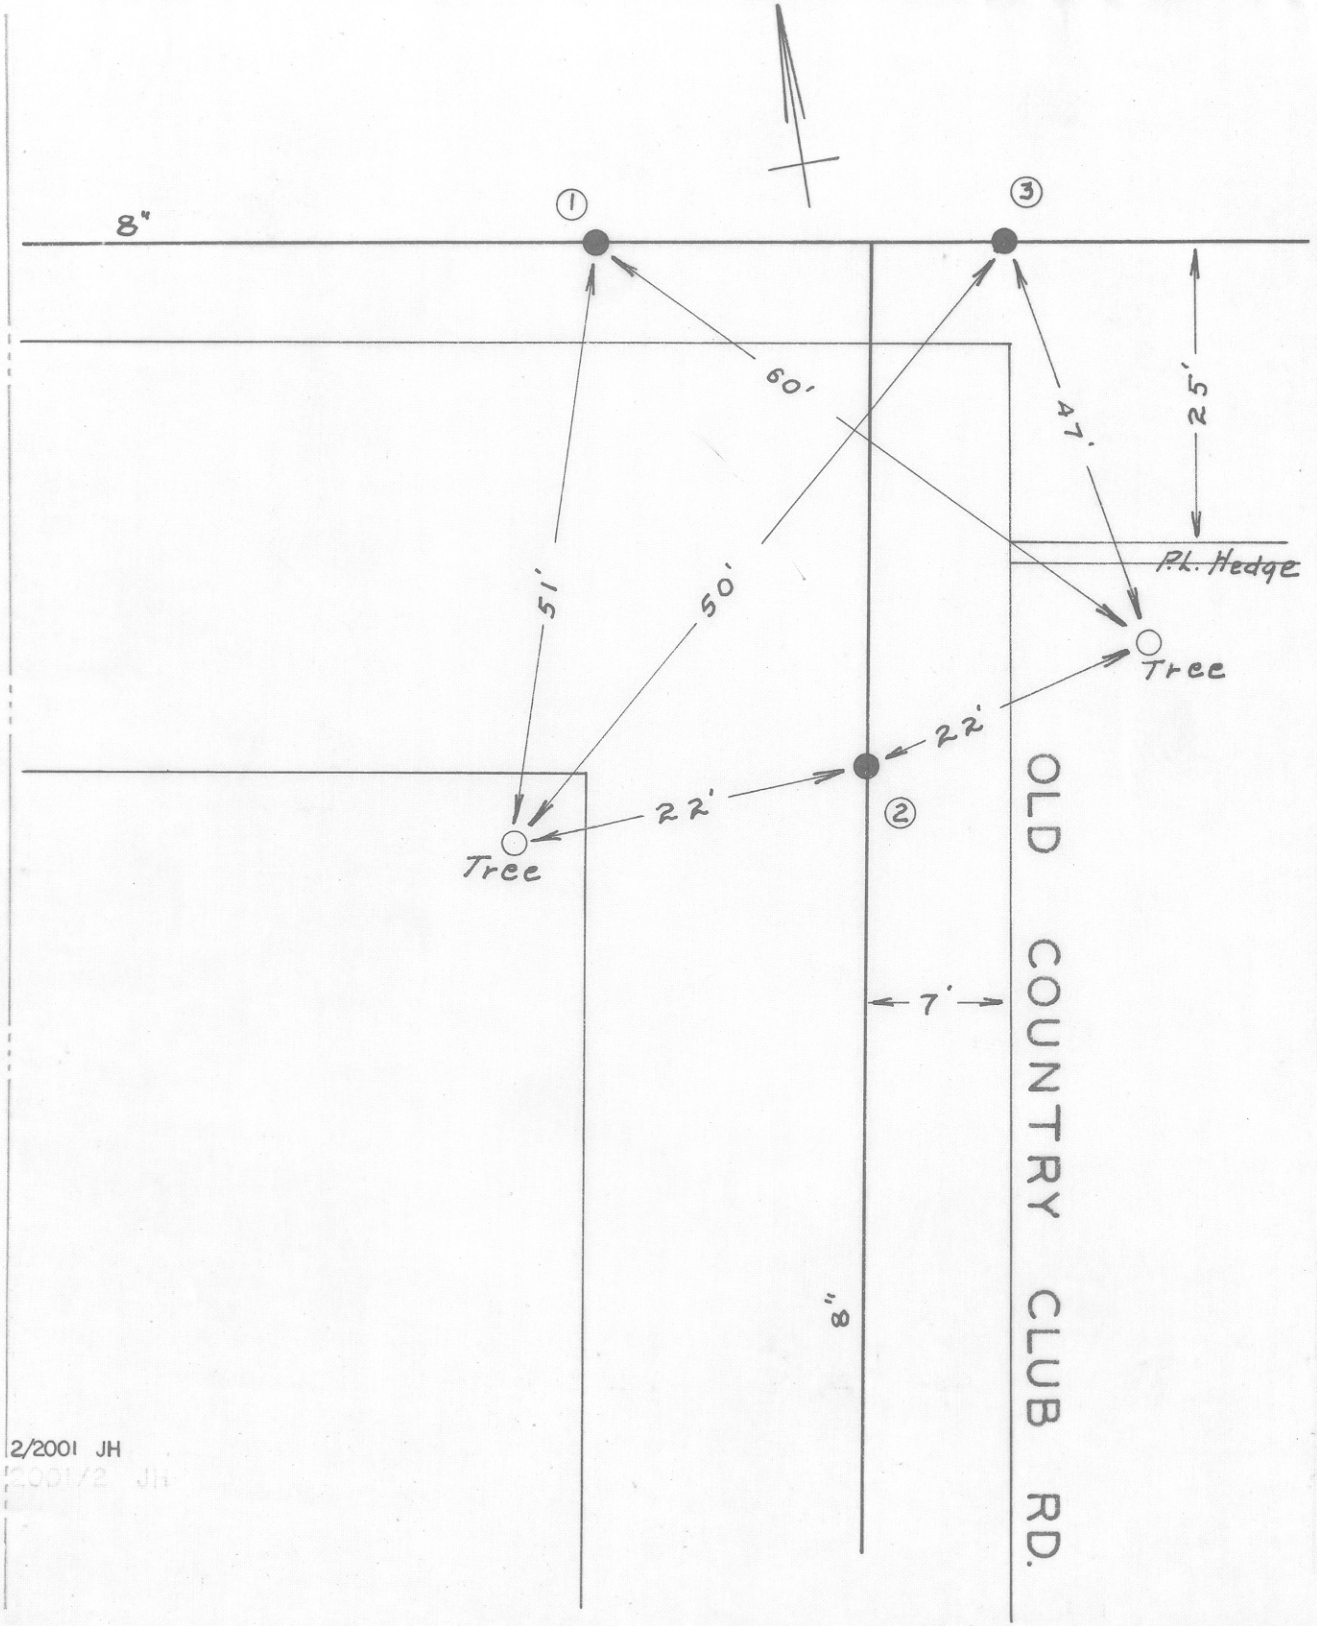

DATE	NO.	SIZE	MAKE	OPEN	TURNS
1952	1	8"	MUELLER	R	27
1950	2	8"	DARLING	R	27
1952	3	8"	MUELLER	R	27
	1	0	WPL		
	2	0	SPL		
	3	0	EPL		

CITY OF ROANOKE—WATER DEPT.

VALVE DIAGRAM

END OLD COUNTRY CLUB RD. AT GOLF COURSE

SEC. MAP 266, 255 N.W.

DATE PAGE NO.

2/2001 JH

"IMPERIAL" TRACING CLOTH K & E CO., N. Y.