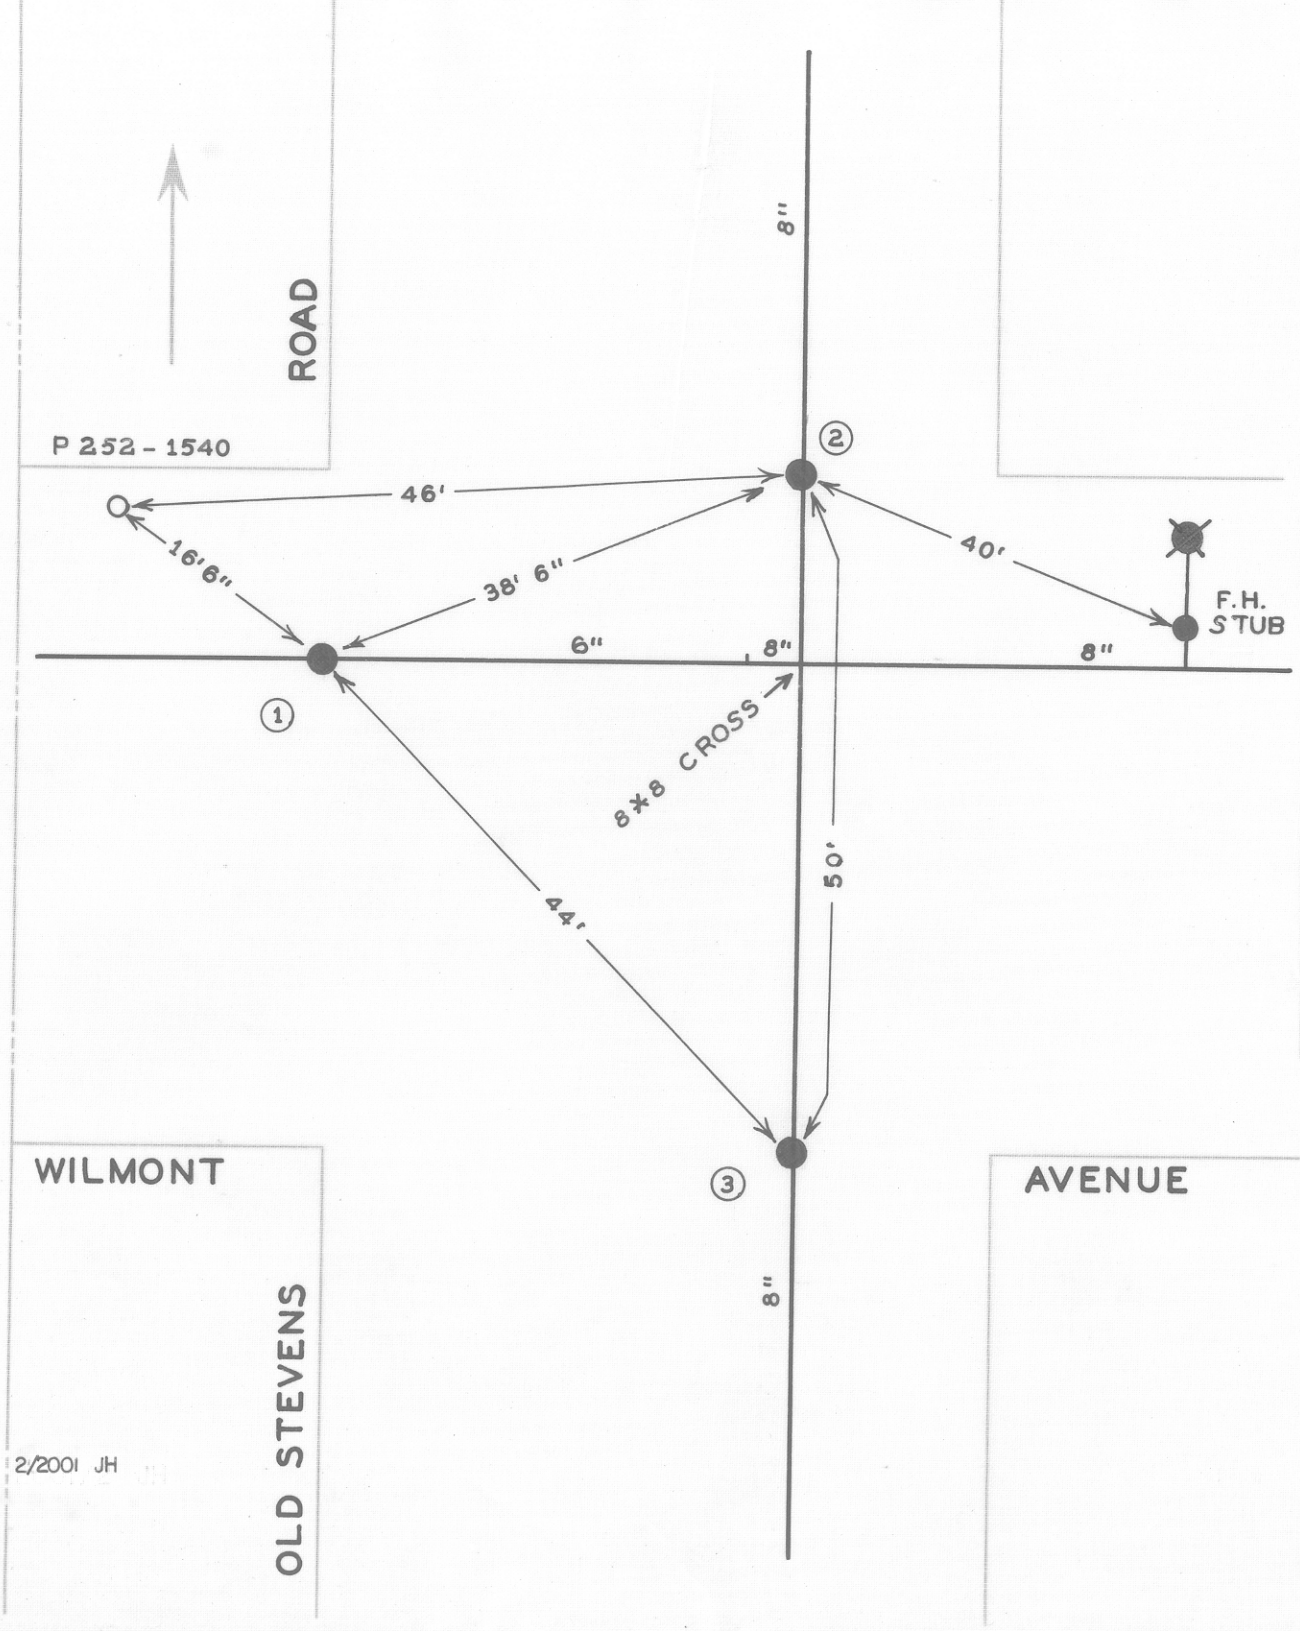

DATE	NO.	SIZE	MAKE	OPEN	TURNS
9-59	1	6"	MUELLER	R	20
9-59	2	8"	DARLING	R	27
9-59	3	8"	MUELLER	R	28
	1	0'	W.P.L.		
	2	0'	N.P.L.		
	3	0'	S.P.L.		

CITY OF ROANOKE—WATER DEP'T

VALVE DIAGRAM

OLD STEVENS ROAD &

WILMONT AVENUE N.W.

N.W.

SEC. MAP 273 NW

DATE PAGE NO.