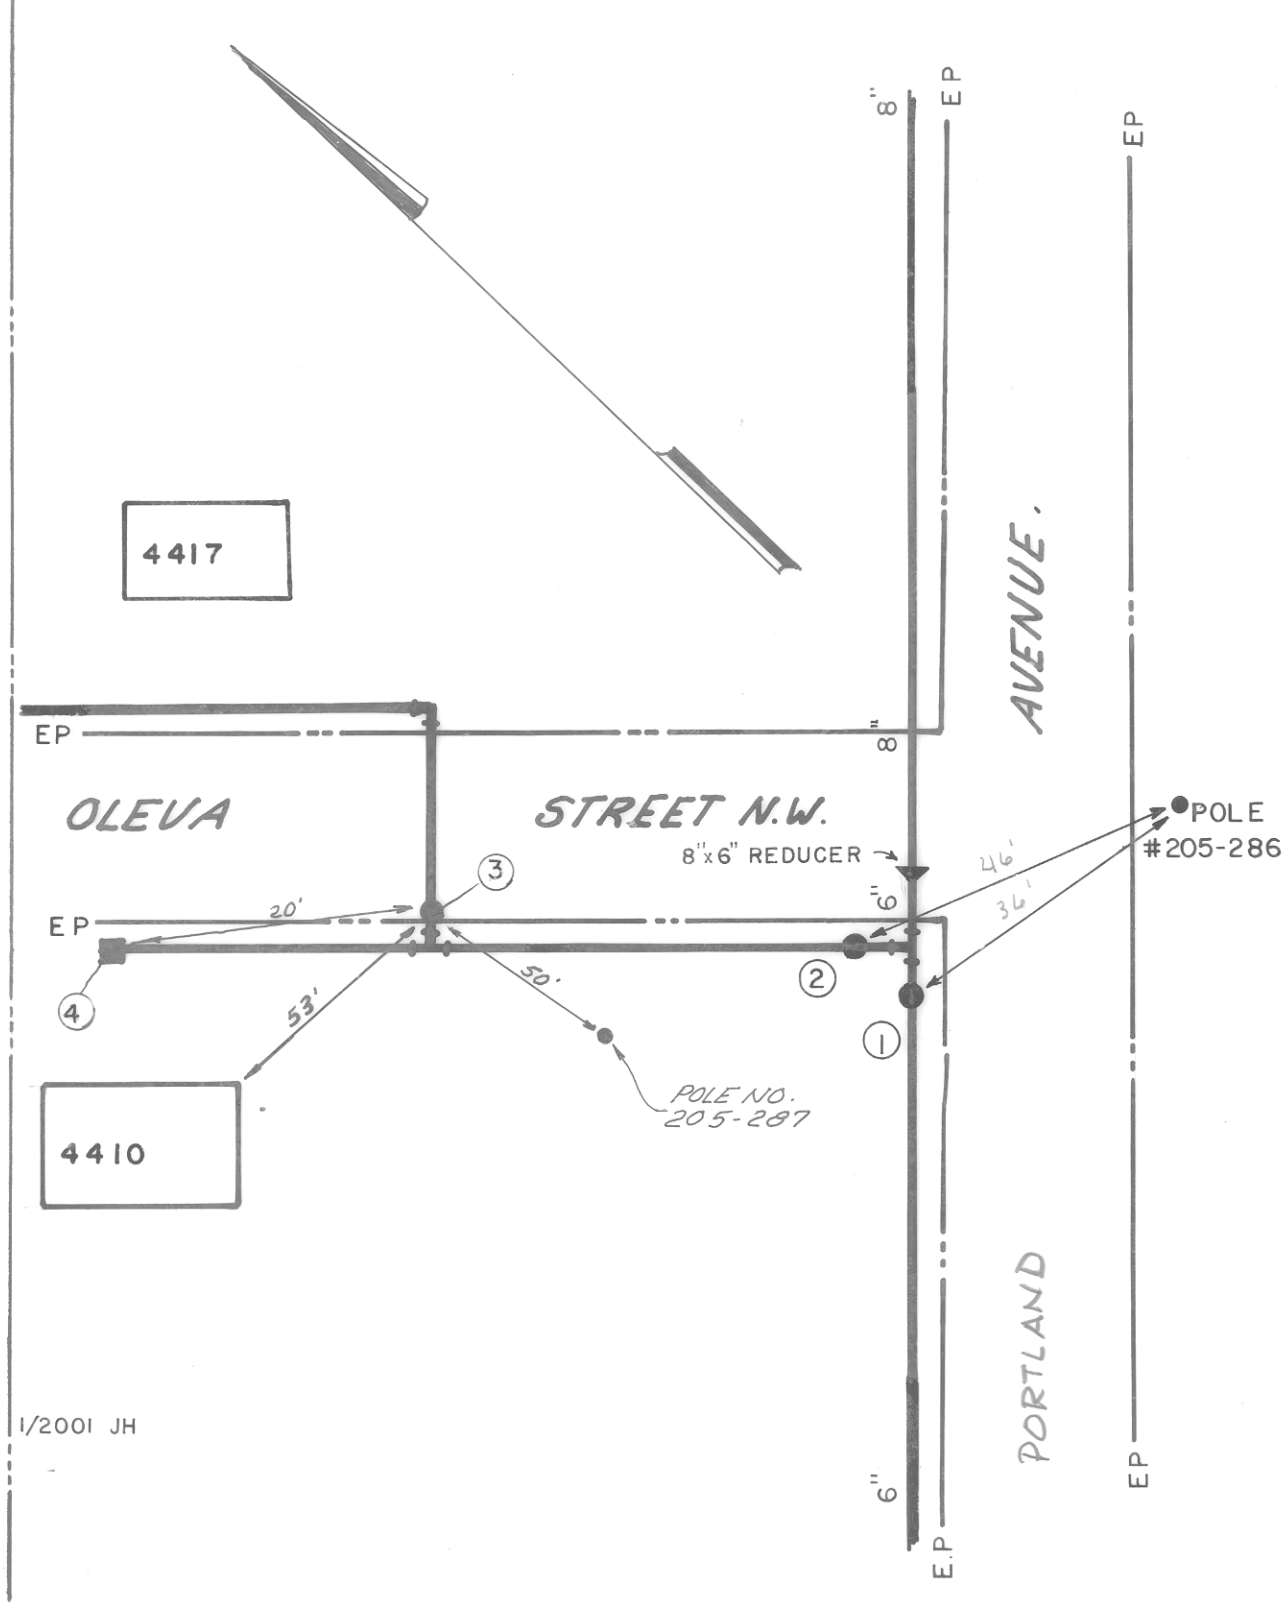

DATE	NO.	SIZE	MAKE	OPEN	TURNS
12/84	1	6"		R	
12/84	2	6"		R	
12/84	3	4"		R	
12/84	4	2"	MISC.	L	

CITY OF ROANOKE—WATER DEP'T

VALVE DIAGRAM

OLEVA STREET AND PORTLAND AVENUE. N.W.

SEC. MAP 641, 642

DATE 4-9-85 PAGE NO.