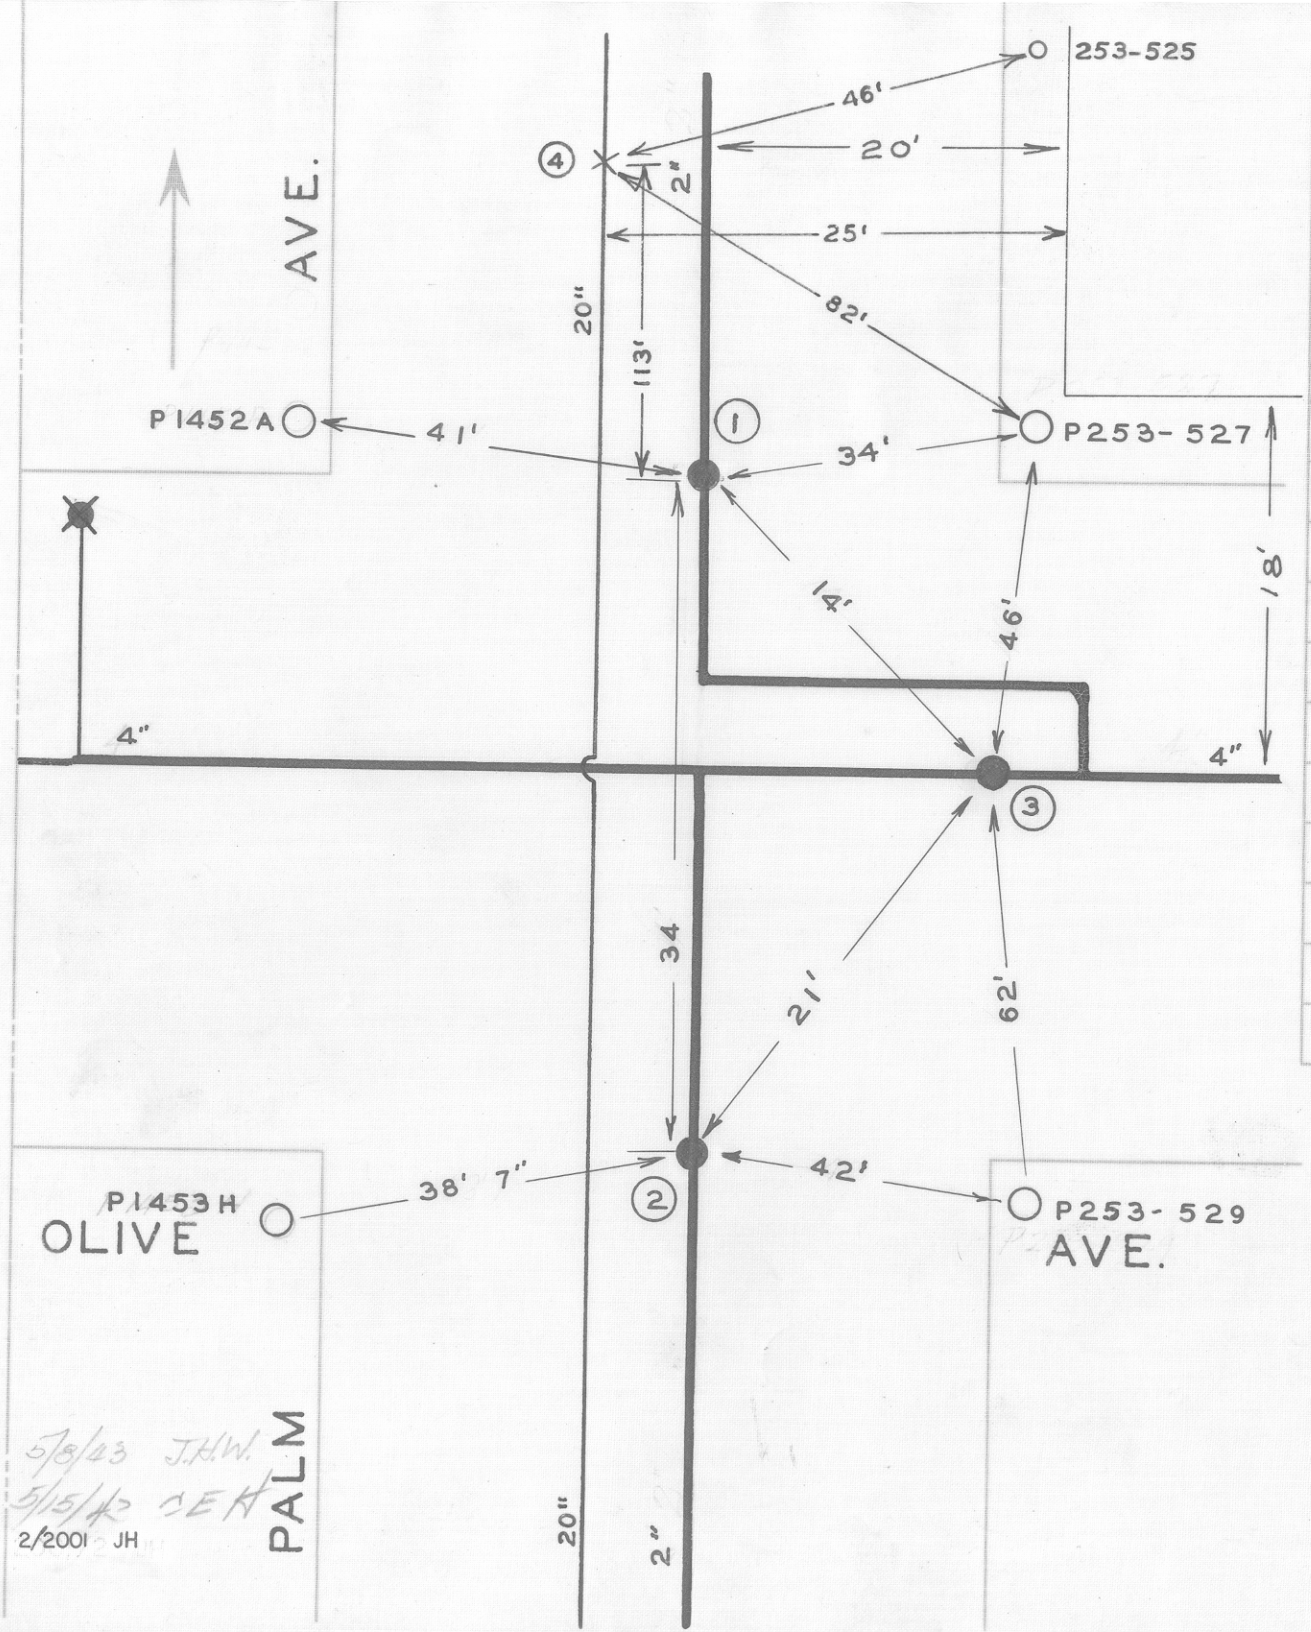

DATE	NO.	SIZE	MAKE	OPEN	TURNS
1927	1	2"		R	9
1926	2	2"		R	8 1/2
1910	3	4"		R	14
12-64	4	1½"	AIR VALVE		
	1	5'-S	NPL		
	2	13'-N	SPL		
	3	17'-W	EPL		

CITY OF ROANOKE—WATER DEP'T

VALVE DIAGRAM

OLIVE AVE. & PALM AVE.

ELM AVENUE

SEC. MAP 243 N.W.

DATE PAGE NO. NW 269