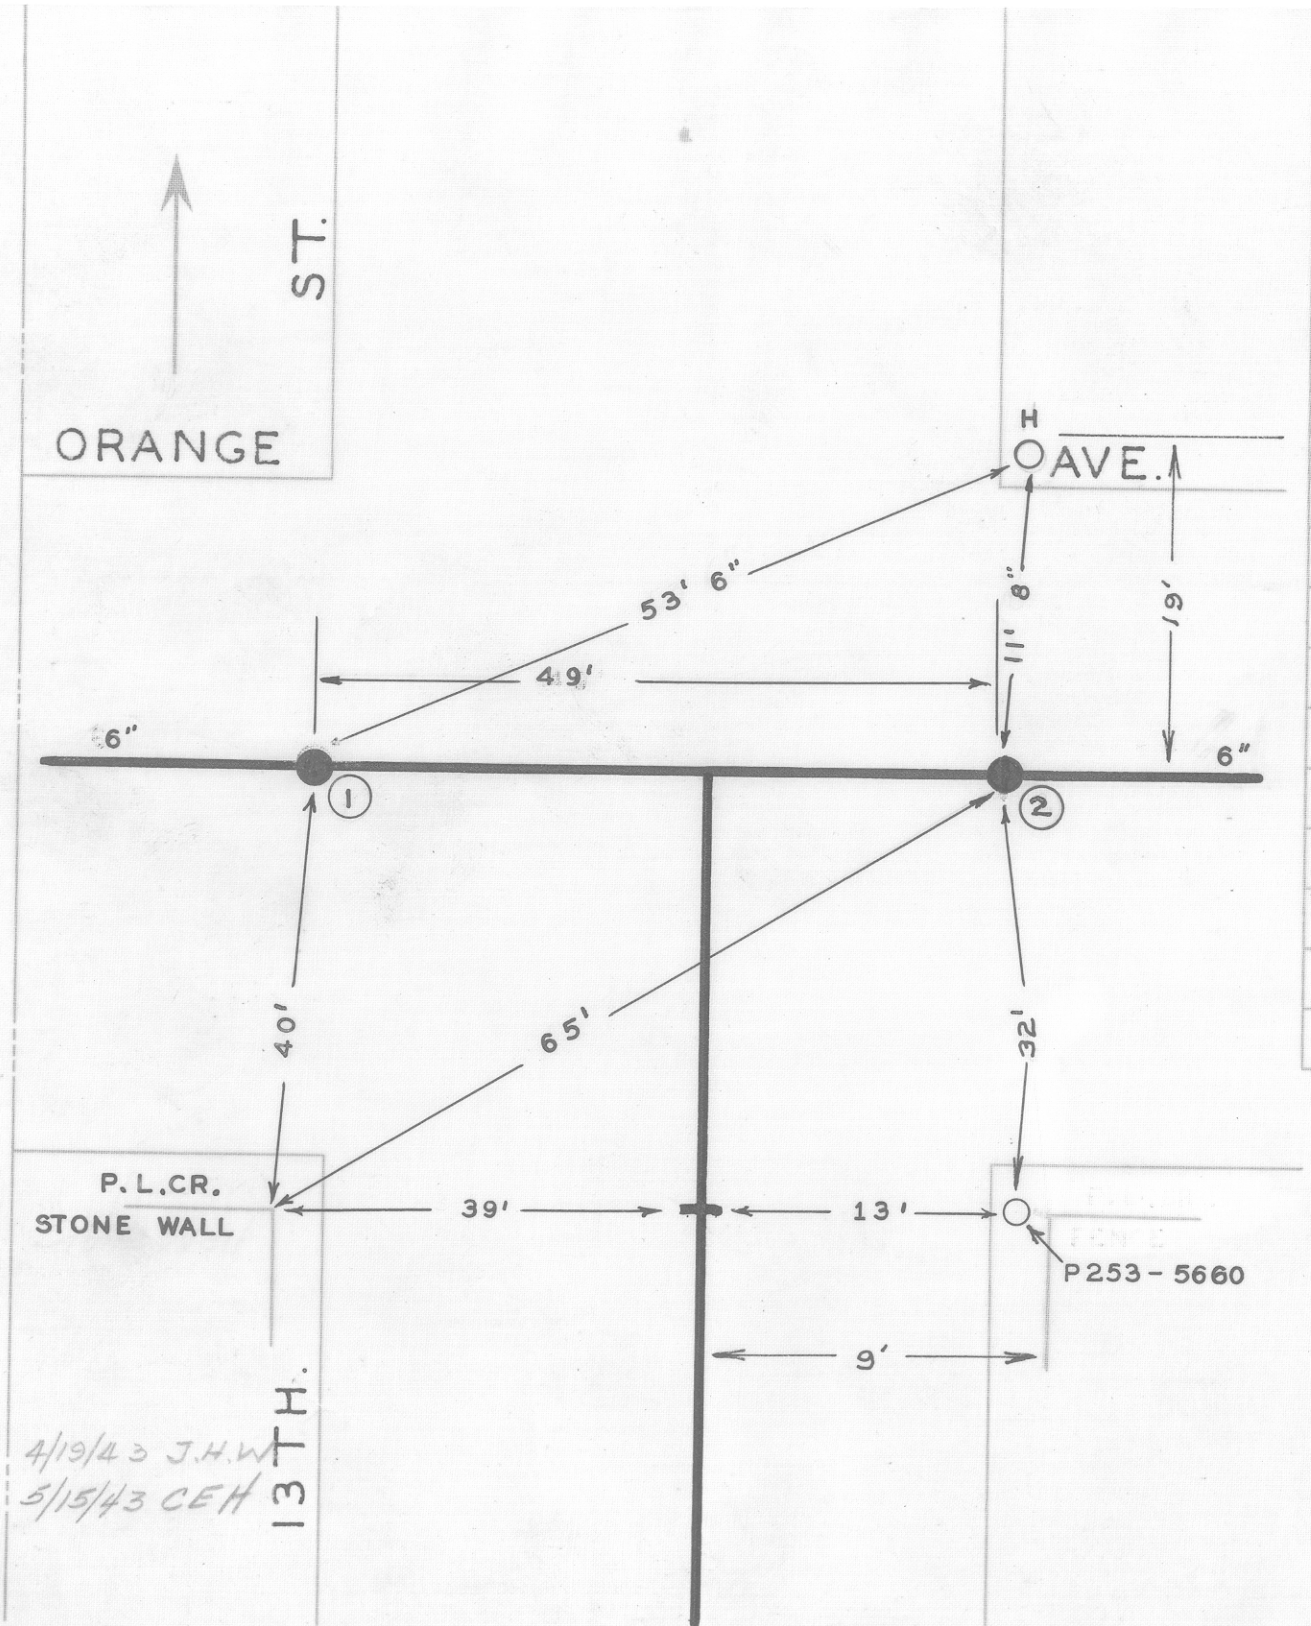

DATE	NO.	SIZE	MAKE	OPEN	TURNS
1891	1	6"		R	13
1891	2	6"		R	20
1947	3	2	DARLING	R	7 1/2
	1	3'-E	WPL		
	2	0	EPL		
	3	0	SPL		

CITY OF ROANOKE—WATER DEP'T

VALVE DIAGRAM

ORANGE AVE. & 13TH. ST. N. W.

SEC. MAP 222

DATE

PAGE NO. NW 147