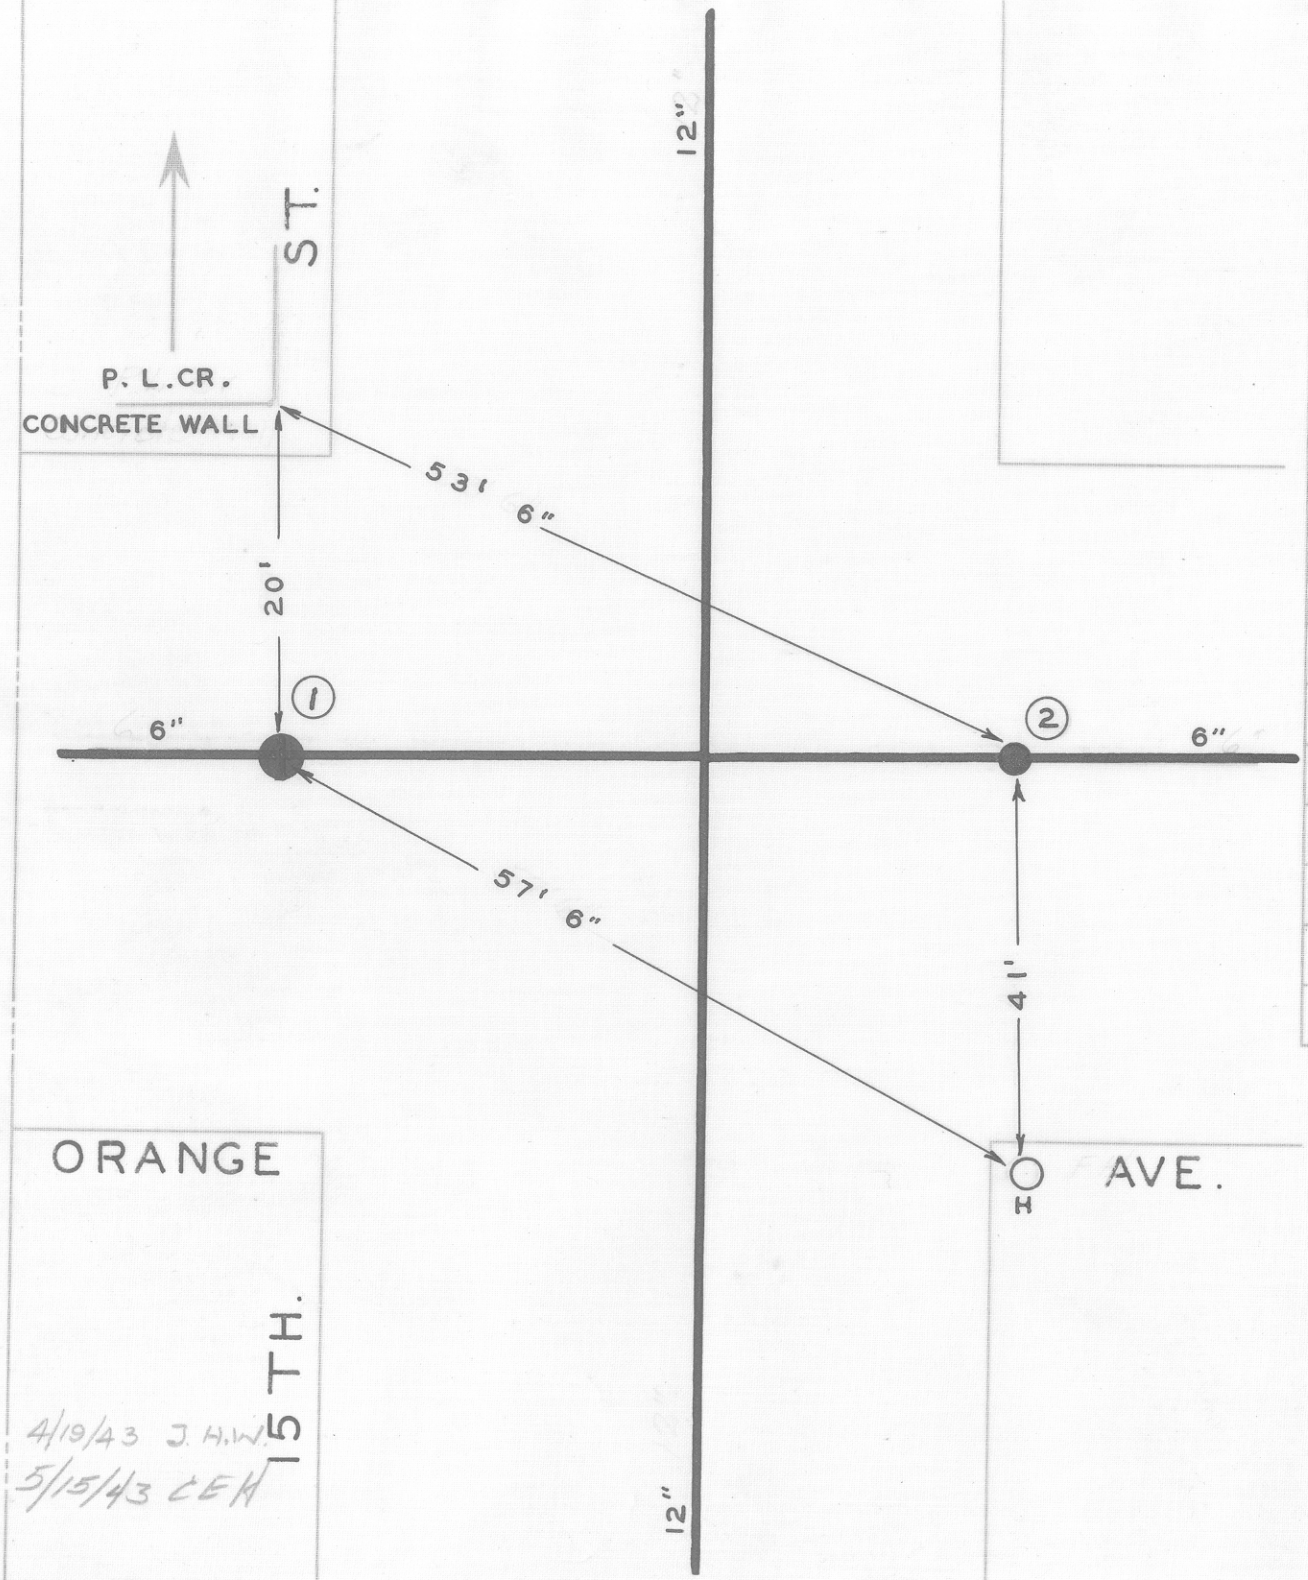

DATE	NO.	SIZE	MAKE	OPEN	TURNS
1891	1	6"		R	21
1891	2	6"		R	20 1/2
	1	0	WPL		
	2	0	EPL		

ORANGE

15TH. ST.

4/19/43 J. H.W.
5/15/43 CEH

CITY OF ROANOKE—WATER DEP'T
VALVE DIAGRAM
ORANGE AVE. & 15TH. ST. N. W

SEC. MAP 222

DATE

PAGE NO. NW 149