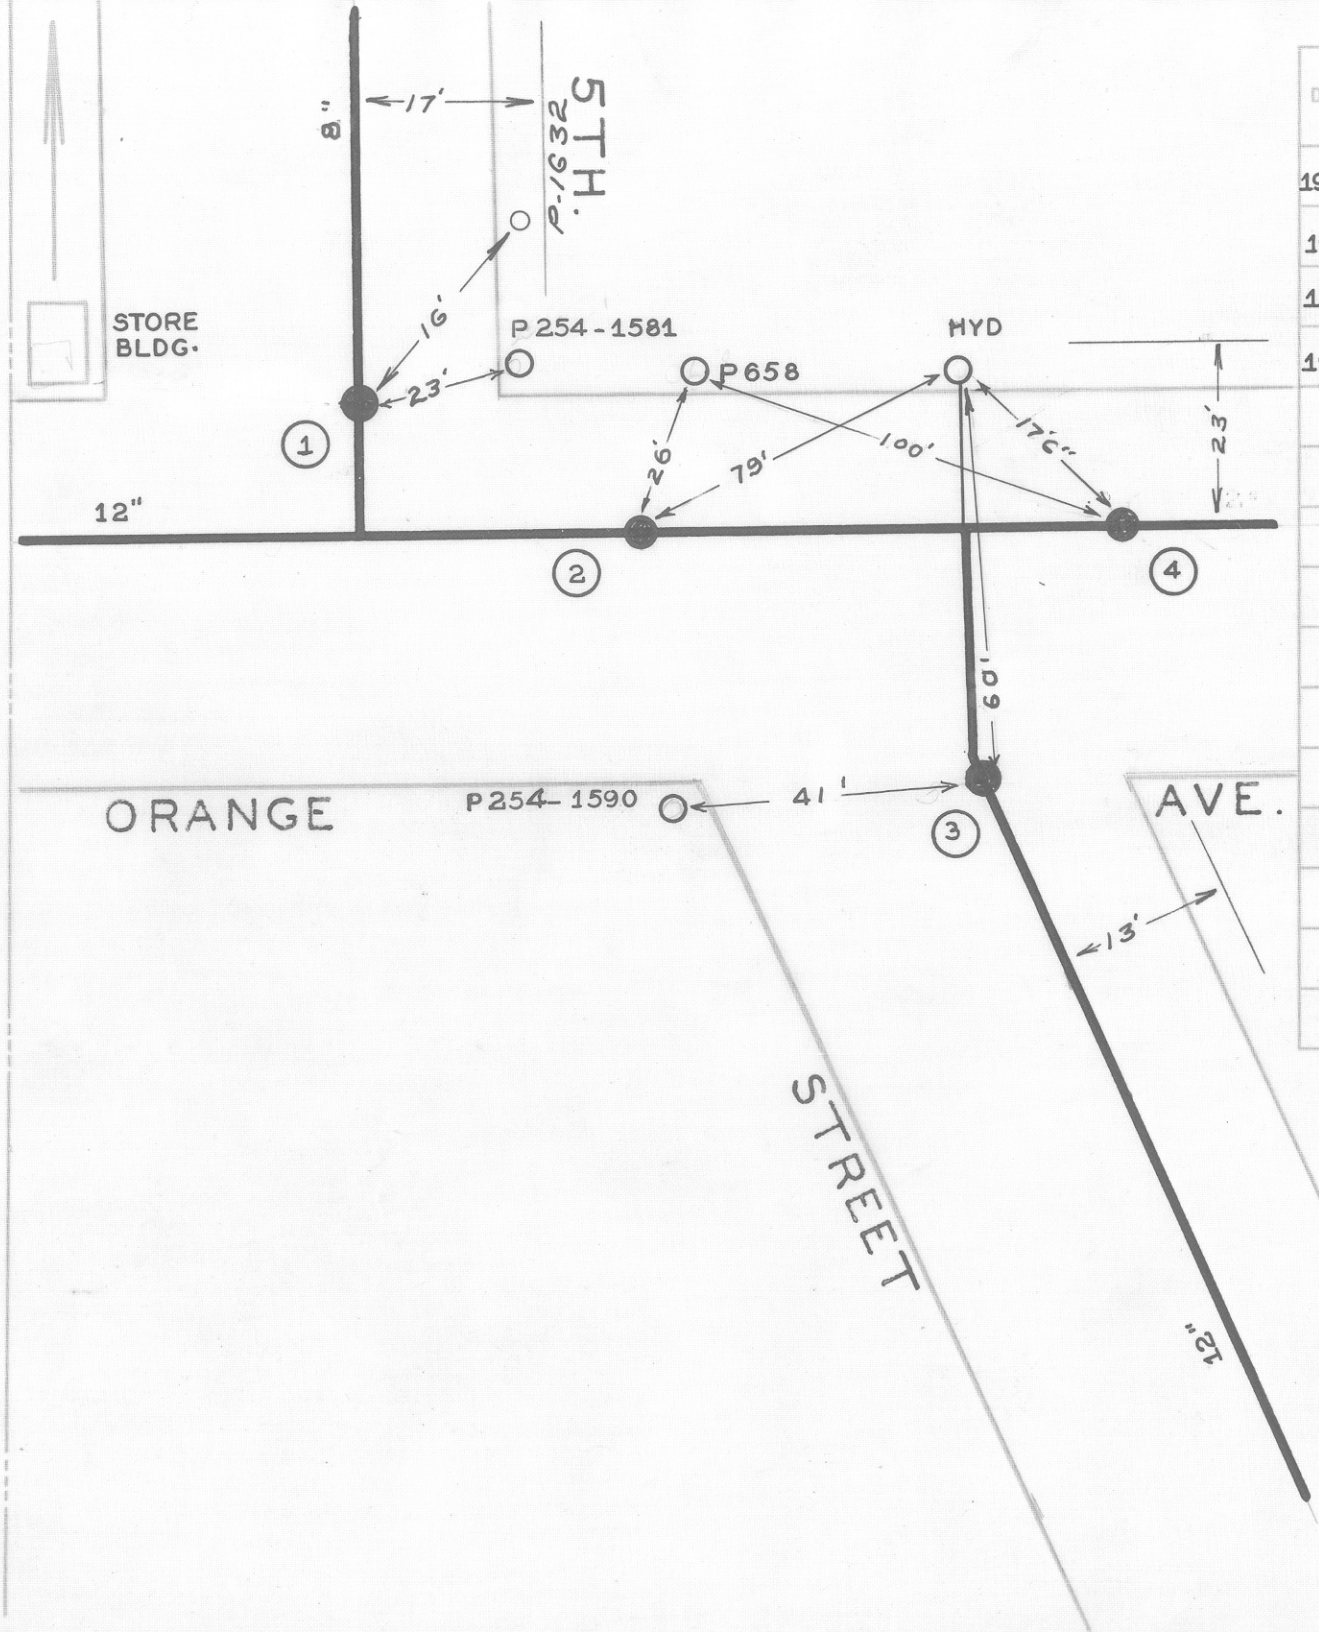

DATE	NO.	SIZE	MAKE	OPEN	TURNS
1949	1	8"		R	27
1948	2	12"	DARLING	R	39
1927	3	12"		R	38
1948	4	8"	DARLING	R	27
	1	4'-S	NPL		
	2	10'-E	WPL		
	3	5'-N	SPL		
	4	18'-E	EPL		

CITY OF ROANOKE—WATER DEP'T

VALVE DIAGRAM

ORANGE AVE. & 5TH. STREET N.W.

SEC. MAP 203

DATE

PAGE NO. N W55