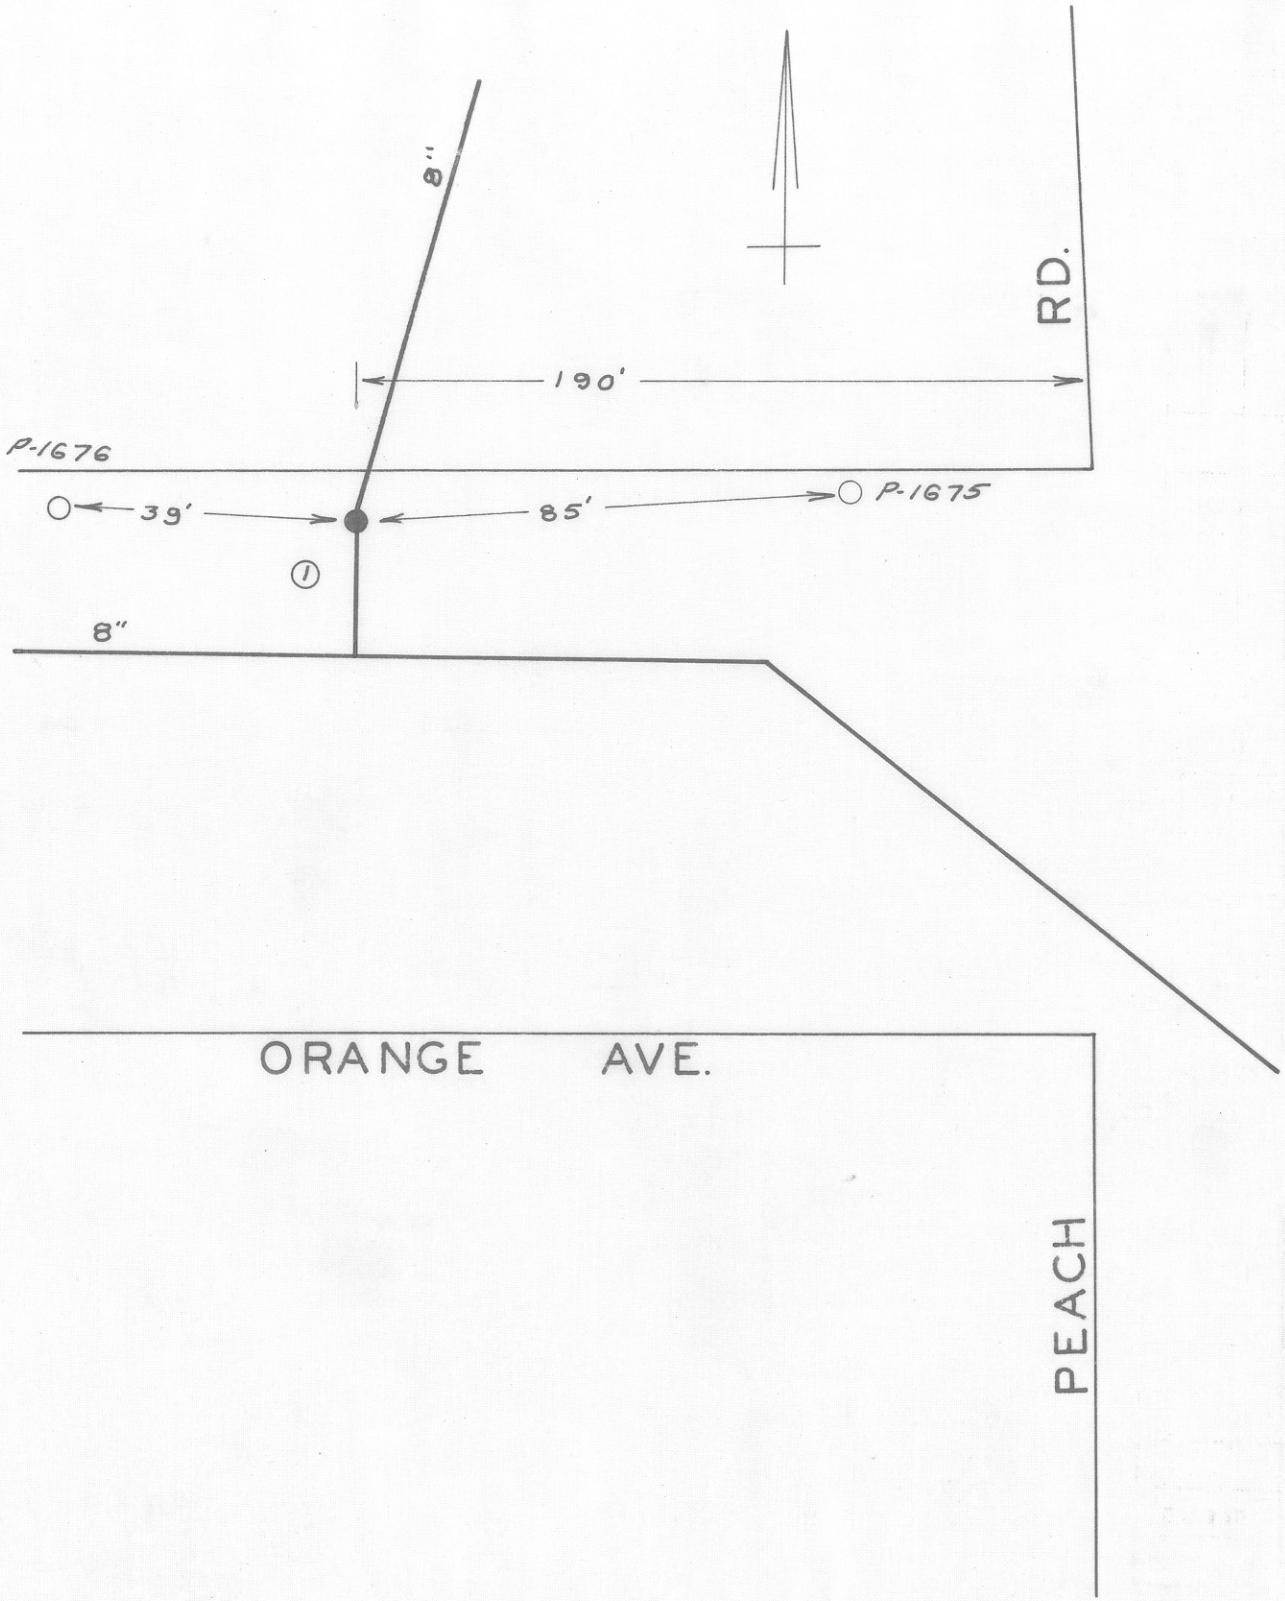

DATE	NO.	SIZE	MAKE	OPEN	TURNS
	1	8"	DARLING	R	20
	1	3'-S	NPL		

CITY OF ROANOKE—WATER DEPT.

VALVE DIAGRAM

ORANGE AVE. 190'-W. OF PEACH RD. N.W.

SEC. MAP 202

DATE PAGE NO.

"IMPERIAL" TRACING CLOTH. K & E CO., N.Y.