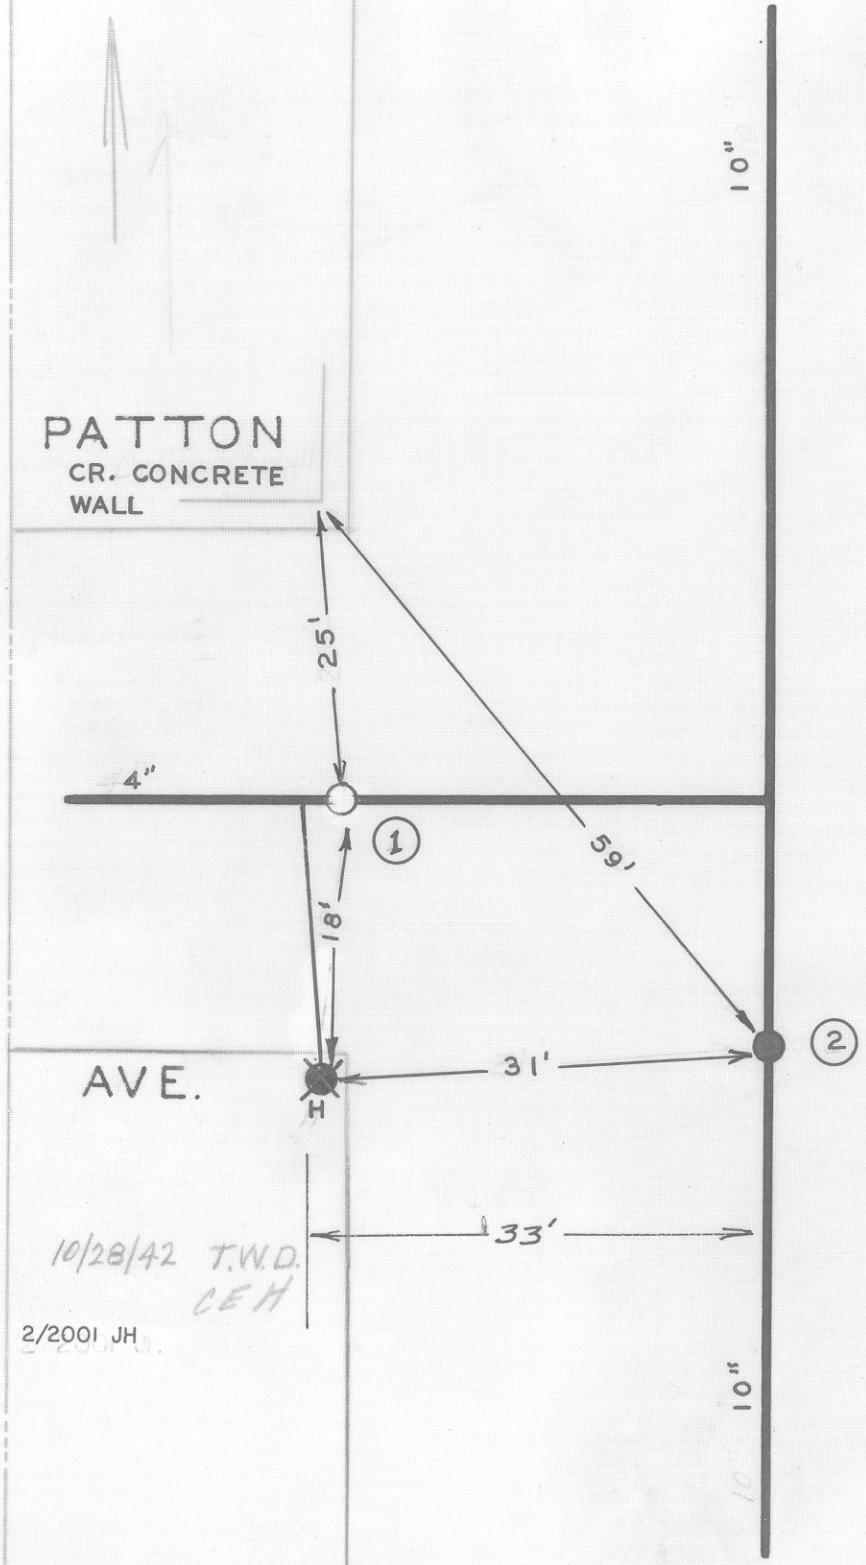

DATE	NO.	SIZE	MAKE	OPEN	TURNS
1890	1	4"		R	21
1891	2	10"		R	36
	1	0	WPL		
	2	0	SPL		

CITY OF ROANOKE—WATER DEP'T
VALVE DIAGRAM

PATTON AVE. & 5TH.
5TH. STREET
SOUTH INTERSECTION

SEC. MAP 201 N.W.

DATE PAGE NO. N.W. 29