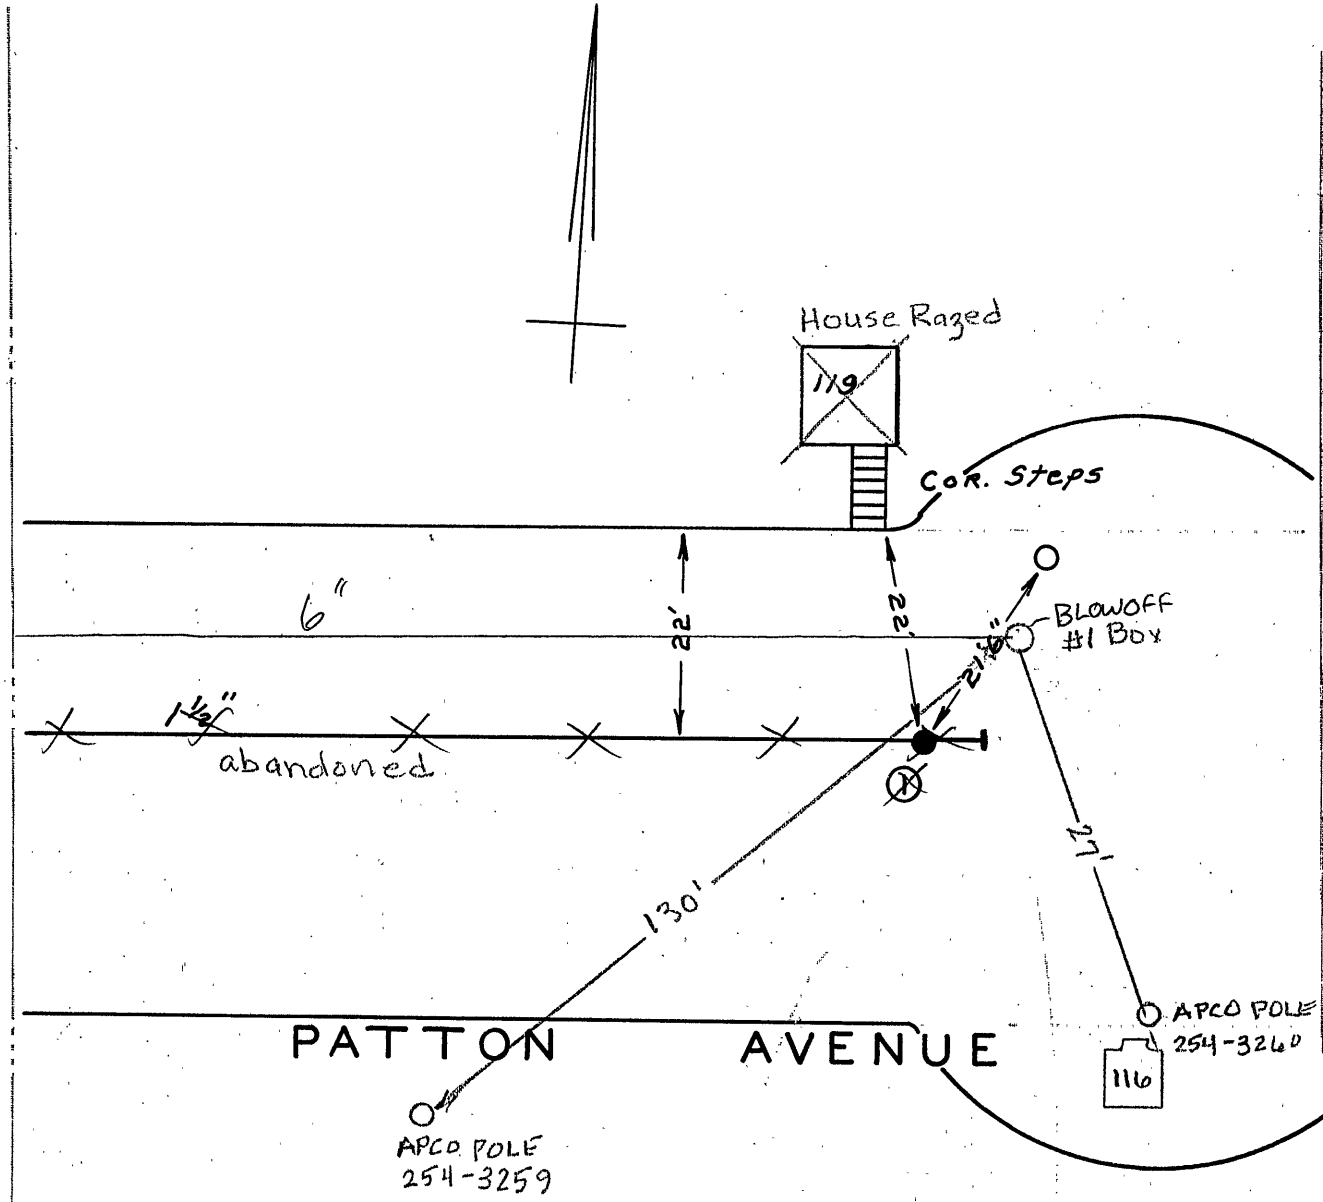

DATE	NO.	SIZE	MAKE	OPEN	TURNS
~~1936~~	~~1~~	~~1½"~~	~~MISC.~~		
6/24 1996	2	2	Misc.		

CITY OF ROANOKE—WATER DEPT.

VALVE DIAGRAM

PATTON AVE.

E. OF 2ND. STREET

SEC. MAP 201 N.W.

DATE PAGE NO.

2/2001 JH