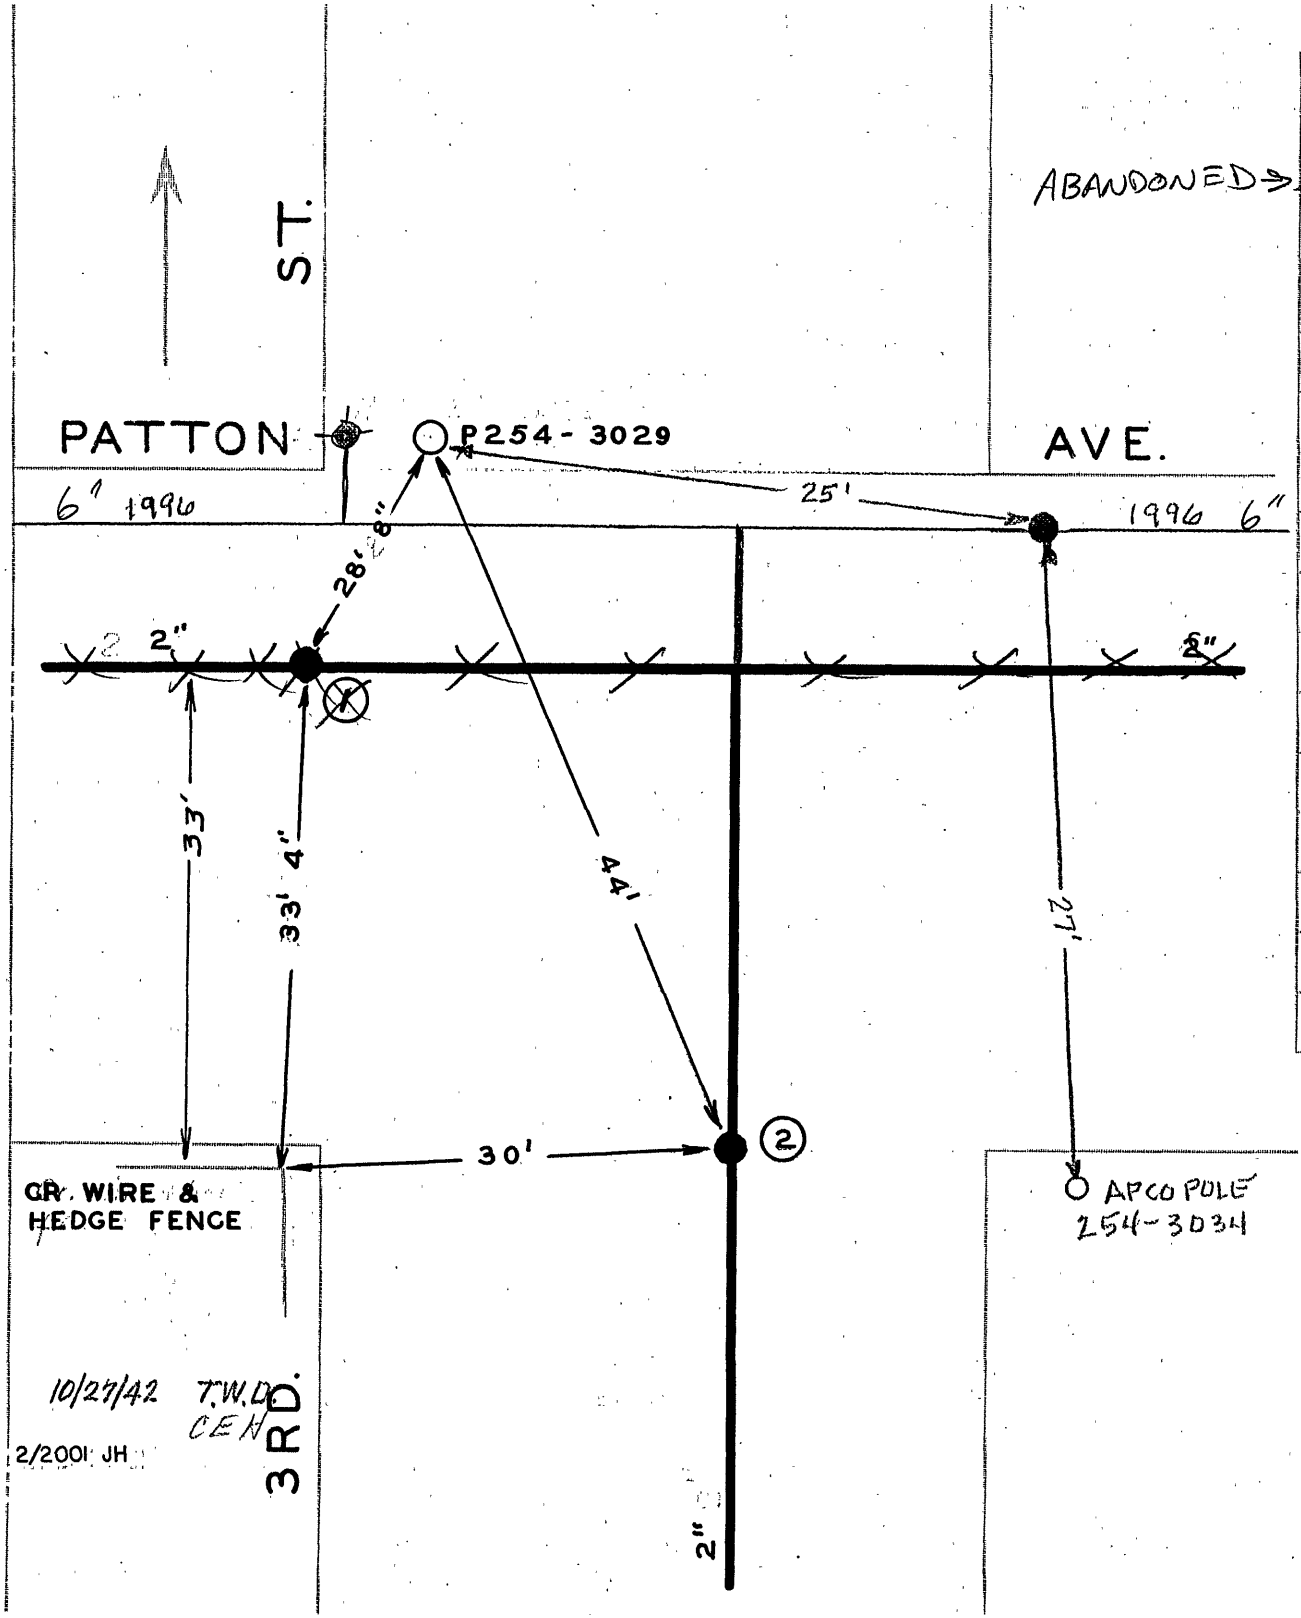

DATE	NO.	SIZE	MAKE	OPEN	TURNS
ABANDONED → ~~1900~~	~~1~~	~~2"~~		~~L~~	~~5~~
1934	2	2"		R	6 1/2
1996	3	6"	MUELLER	R	21
	1	8-W	WPL		
	2	0	SPL		

CITY OF ROANOKE—WATER DEP'T

VALVE DIAGRAM

PATTON AVE. &

3 RD STREET

SEC. MAP 201 N.W.

DATE PAGE NO. N.W.26